




NOTE:

ELEVATIONS SHOWN ARE IN NEW BEDFORD CITY DATUM.

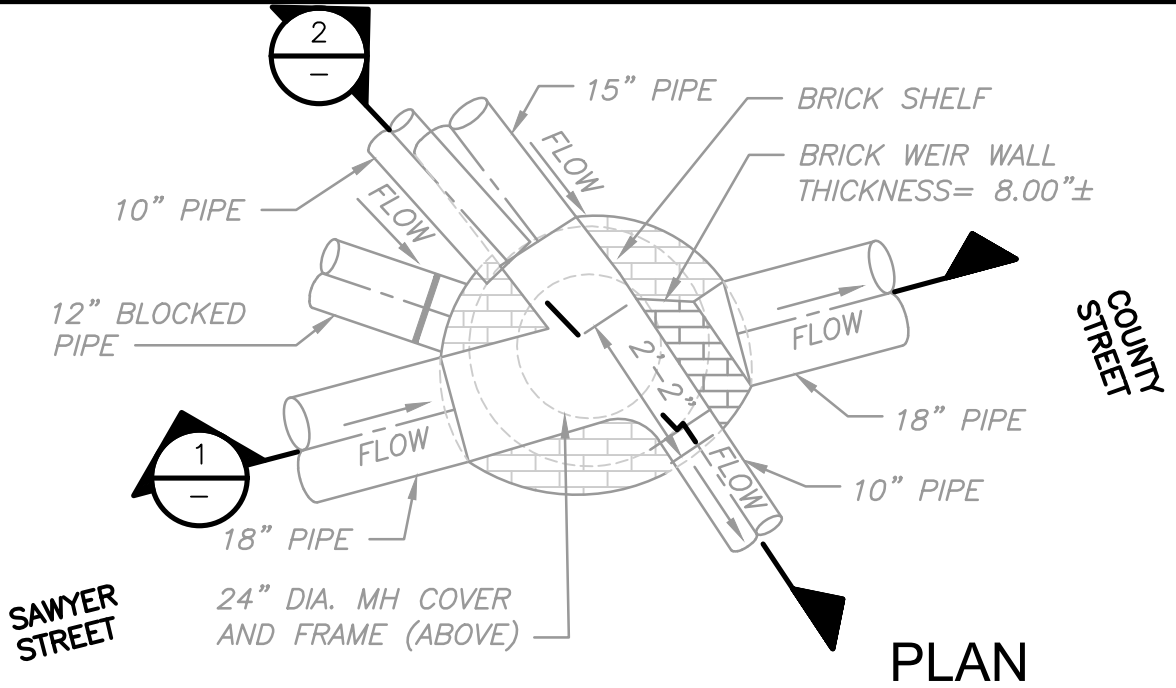