

CSO SPEC SHEET

Structure #: REG 022 G

Date: 09/27 / 2012

Insp. By: AK & AH

Location: At the Intersection of Holly St. and Belleville Ave.

Structure Type: Brick Weir Wall

Regulator Type: Block Regulator

Structure DIM's: _____

Weir Dim's: _____

Size of Sewer Pipe: _____

Rim to Weir Wall: 6.3'

Size of Storm Drain Pipe: _____

Rim to Storm Drain Invert: _____

Sewer Direction: North and West to East

Rim to Top of Sewer (Normal Flow): 7.0'

Free Board: 0.7'

Over All Rating: (Circle One)

Poor


Fair

Good

Excellent

Comments: No Repairs Needed.

Field Sketch:

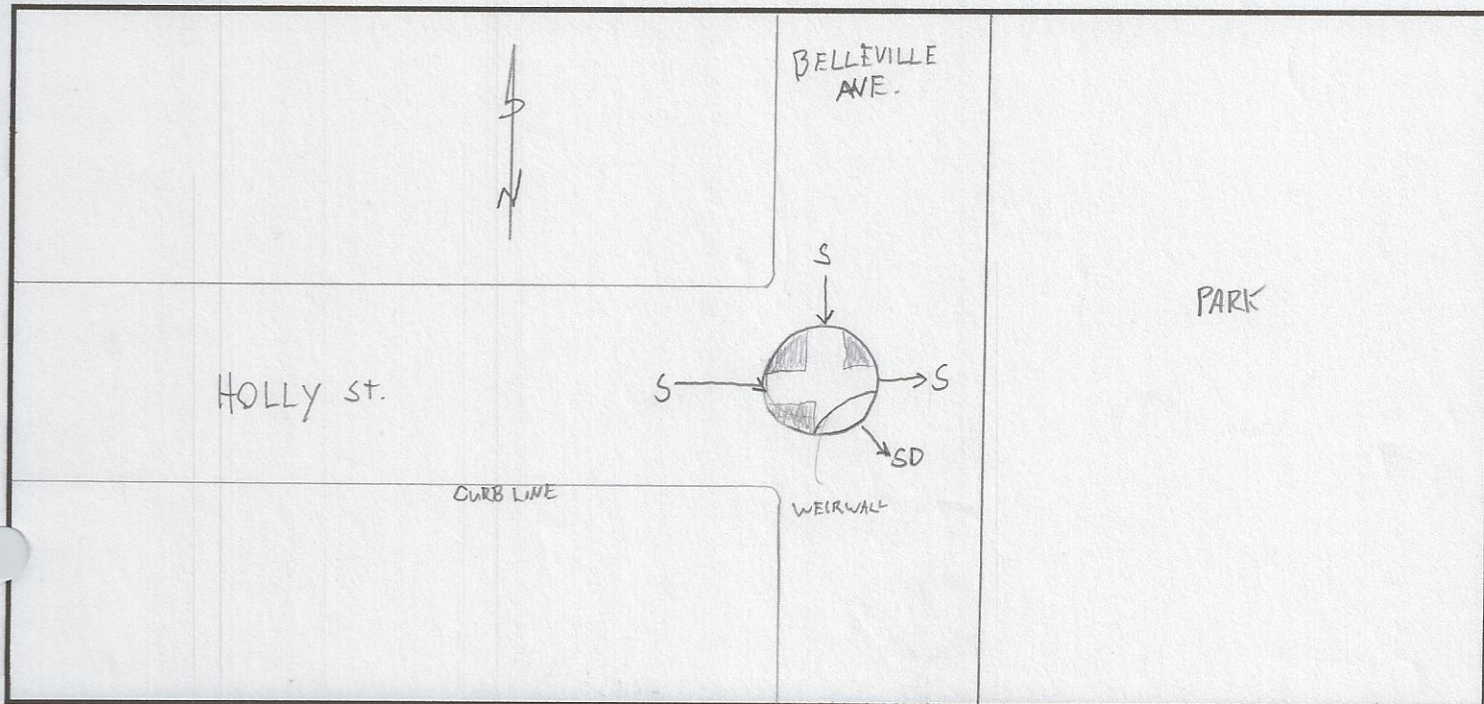

CSO FIELD PHOTOS

Structure#: REG 022 G

Location: At the Intersection of Holly St. and Belleville Ave.


Figure 1.



Figure 2.



Figure 3.

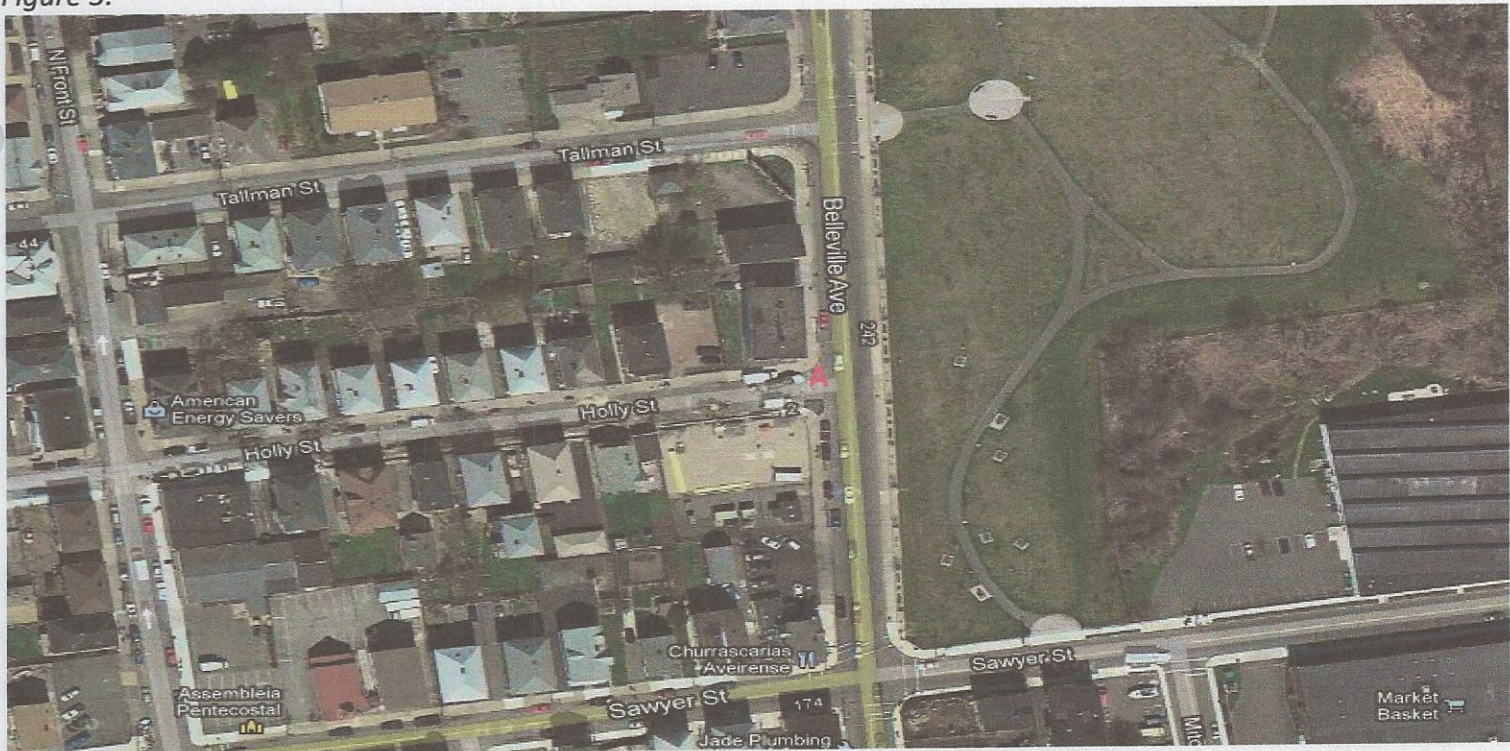


Descriptions

Figure 1: View of Regulator 022 G. Facing North.

Figure 2: Inside view of manhole. A- Sewer; B- Weir Wall; C- Storm Drain.

Figure 3: Google Earth Image of location of Regulator 022 G. A- Reg 022 G.

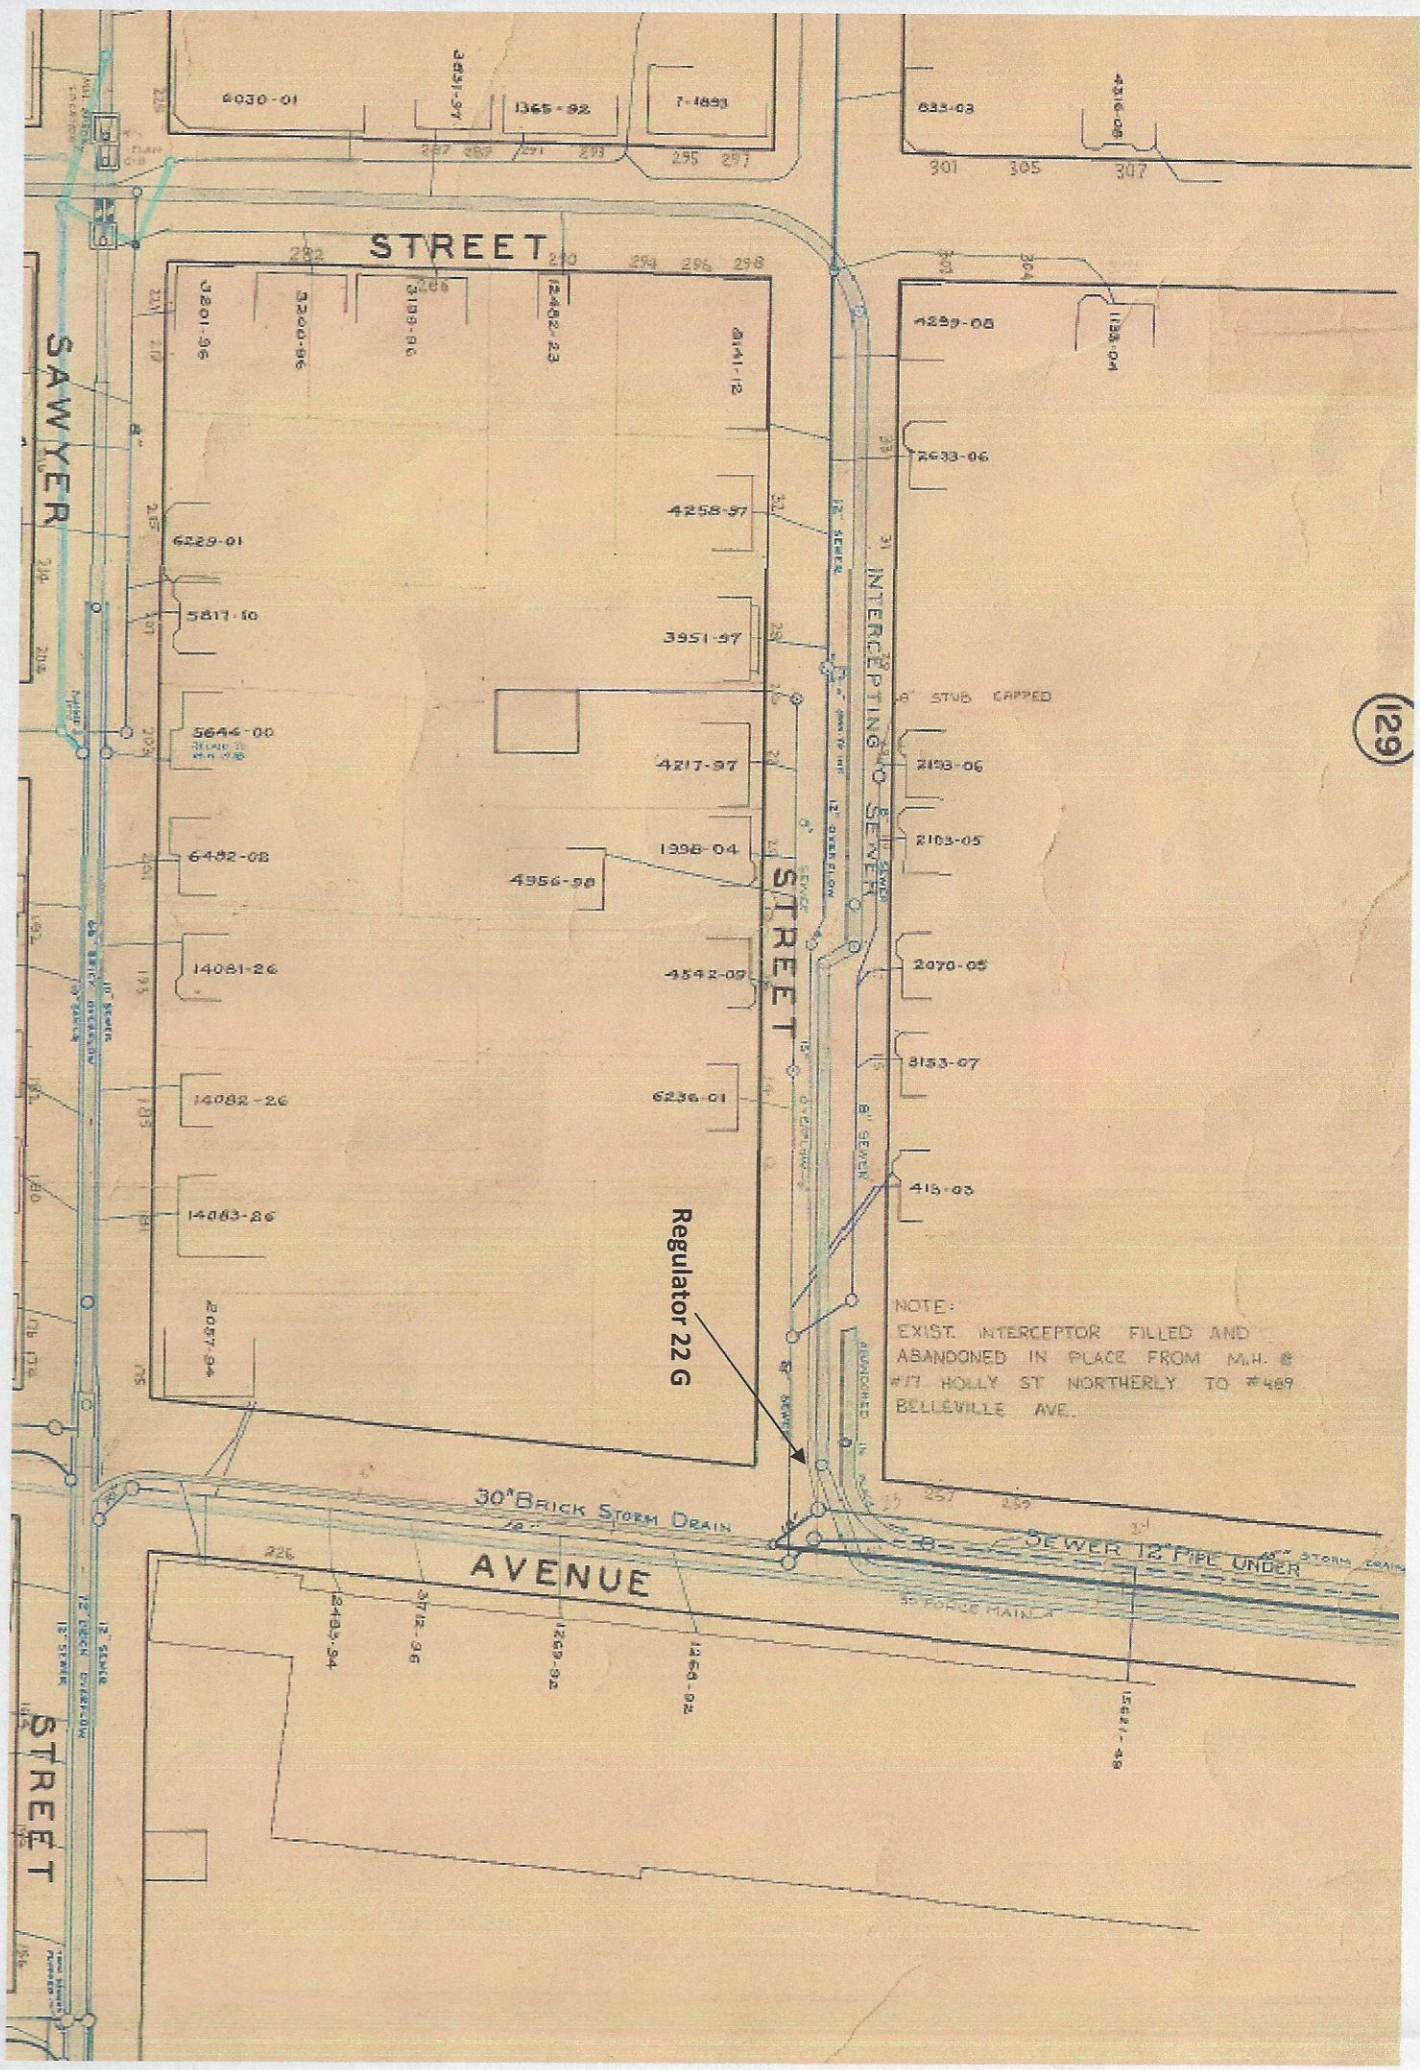

CSO/Regulator Repair log

Structure #: Reg 022 G

[illegible]