




METER SITE INFORMATION FIELD LOG

PROJECT: New Bedford, MA	DATE: March 27, 2025	JOB#: 25029
LOCATION: 2415 Purchase Street	MH#: ~	METER SITE: Site 16
GPS/COMMENTS: 41.6609281, -70.9348342		



	Size (")	Material	Flow Depth (")	Debris	Shape	MH Depth
Incoming	36	RCP	5.5	0	Circular	9' 1"
Incoming	20	CIP	3	0	Circular	9' 0"
Incoming						
Outgoing	36	RCP	5.9	0	Circular	9' 2"

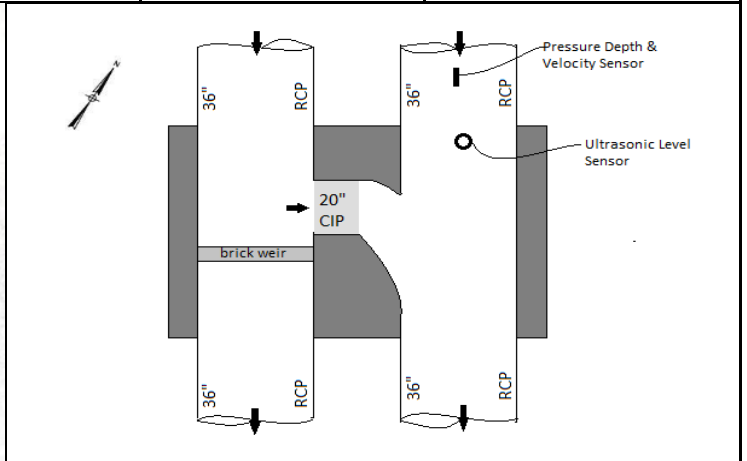

SURCHARGE INFORMATION

SURCHARGE NONE EVIDENT: X
SURCHARGED MARKS TO:
SURCHARGE CURRENTLY TO:

WEIR INFORMATION

LENGTH:	HEIGHT ABOVE WEIR:
BREADTH:	OVERFLOW OCCURS AT:
LEVEL:	

