

CSO SPEC SHEET

Structure #: REG 023 A

Date: 09/19/2012

Insp. By: AK & AH

Location: At the Intersection of Coffin Ave and Riverside Ave.

Structure Type: Concrete Weir Wall

Regulator Type: Block Regulator

Structure DIM's: _____

Weir Dim's: _____

Size of Sewer Pipe: 24"

Rim to Weir Wall: 6.0'

Size of Storm Drain Pipe: 42"

Rim to Storm Drain Invert: _____

Sewer Direction: West to East

Rim to Top of Sewer (Normal Flow): 8.0'

Free Board: 2.0'

Over All Rating: (Circle One)

Poor


Fair

Good

Excellent

Comments: No Repairs Needed.

Field Sketch:

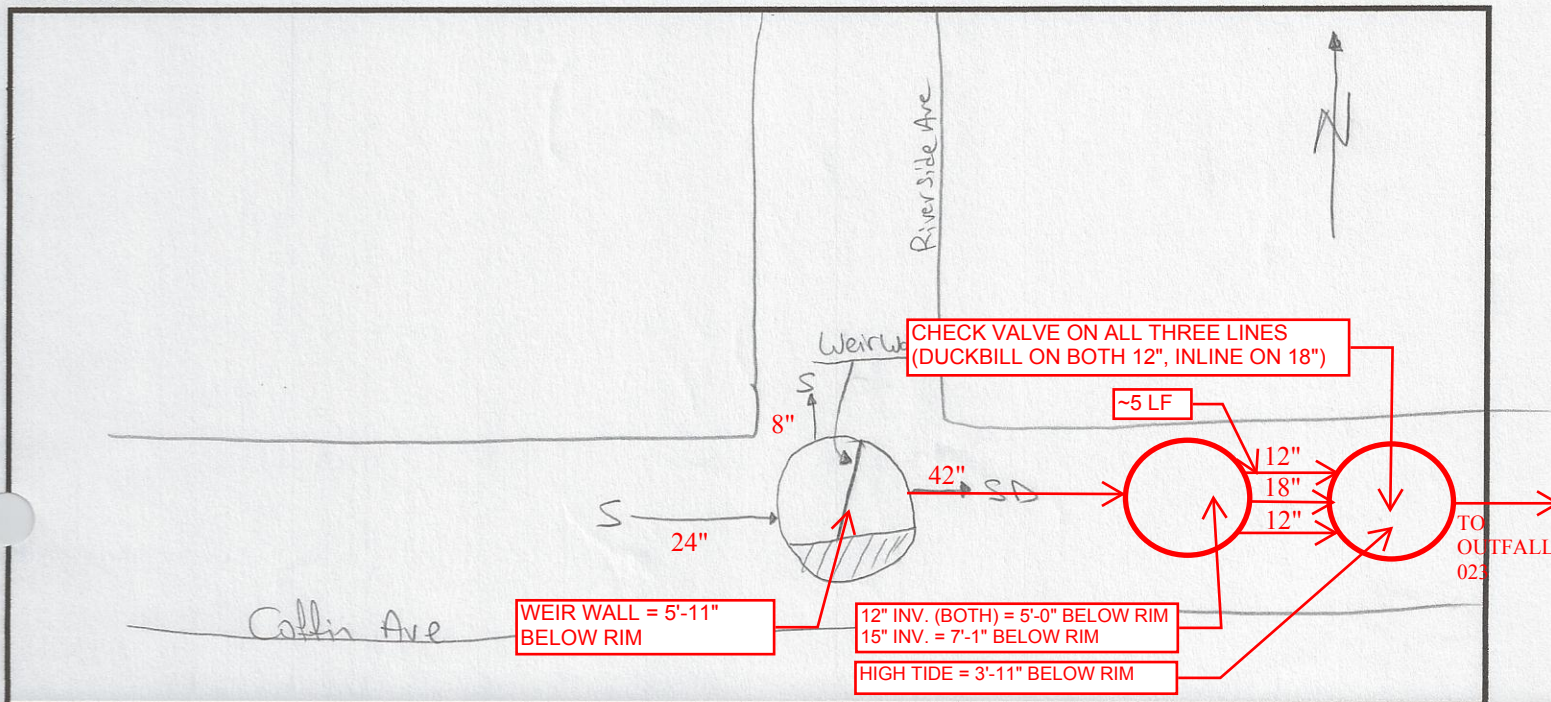

CSO FIELD PHOTOS

Structure#: REG 023 A

Location: At the Intersection of Coffin Ave and Riverside Ave.

Figure 1.


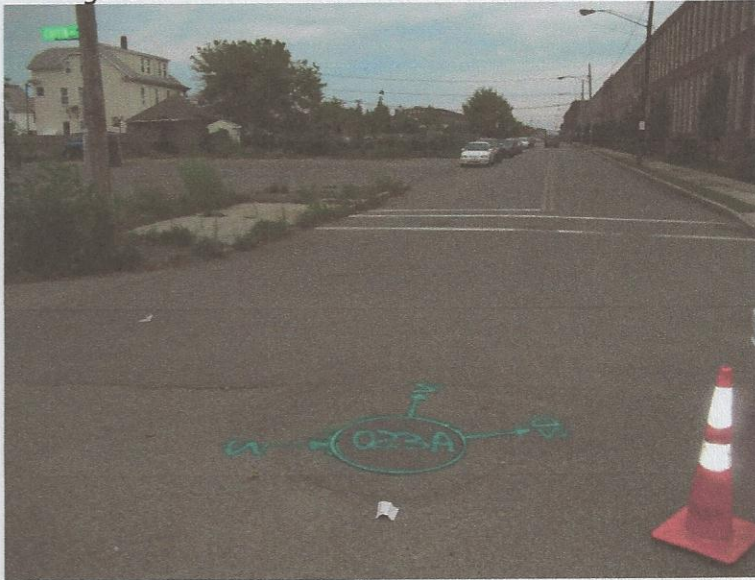


Figure 2.



Figure 3.

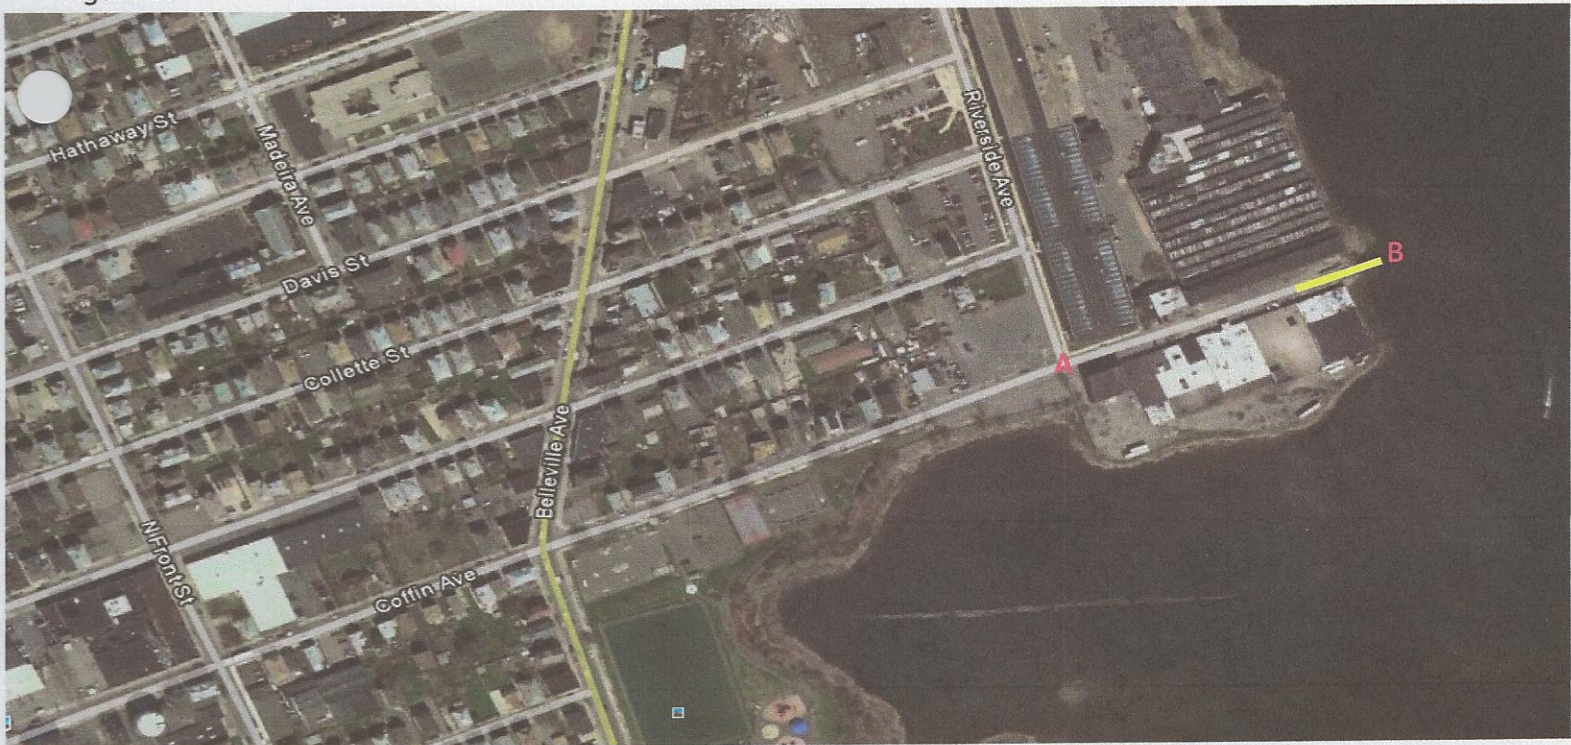

Descriptions

Figure 1: View of Regulator 023 A. Facing North.

Figure 2: Inside view of manhole. A- Sewer; B- Weir Wall; C- Storm Drain.

Figure 3: Google Earth Image of location of Regulator 023 A. A- Reg 023 A. B- CSO 023 Outfall.

