


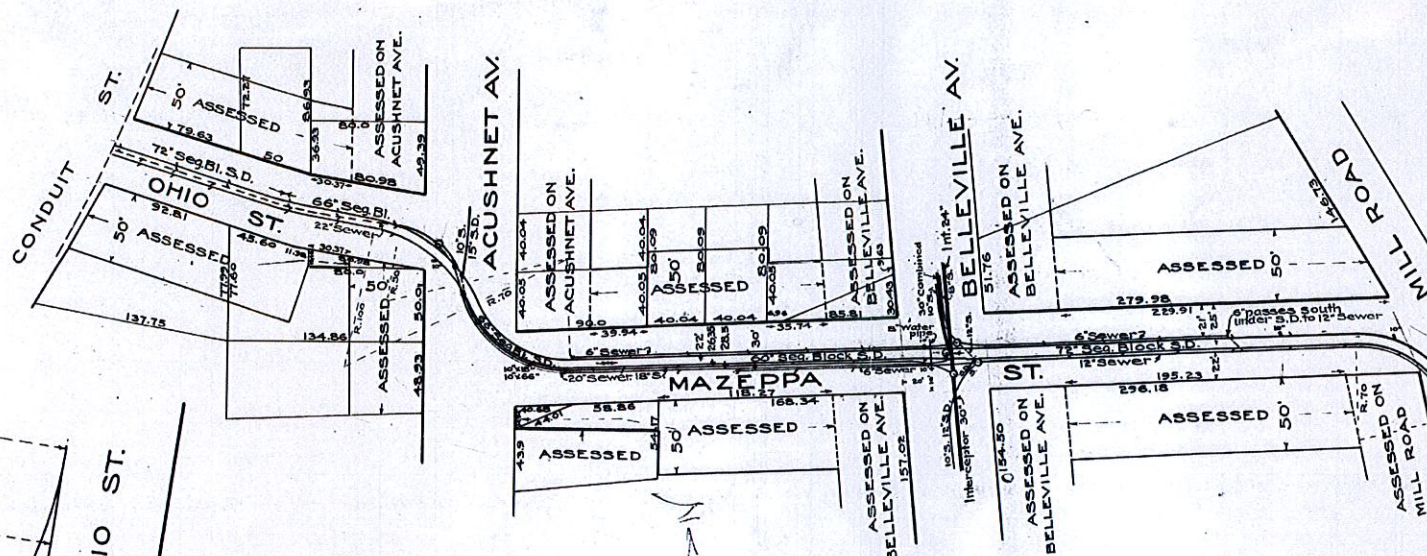


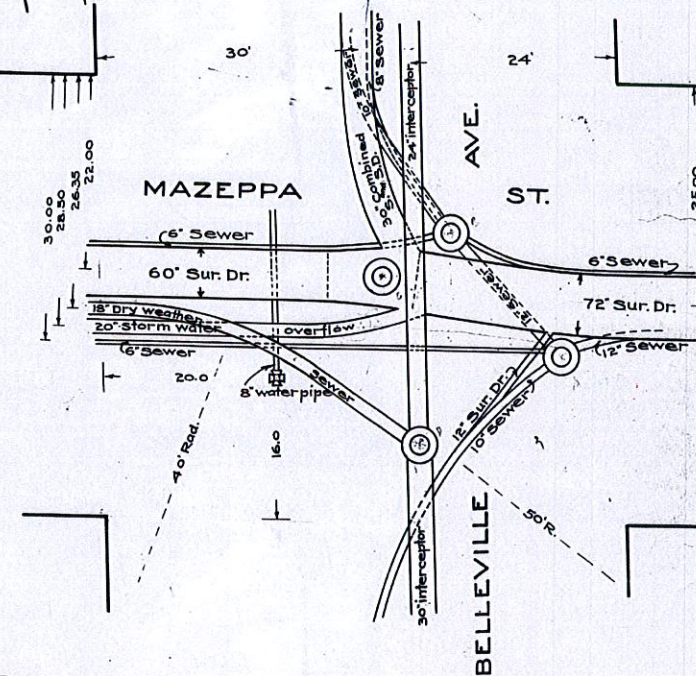

PLAN SHOWING CONSTRUCTION
AT MAZEPPA ST. AND BELLEVILLE AVE.
Scale; 1 in. = 10 ft.

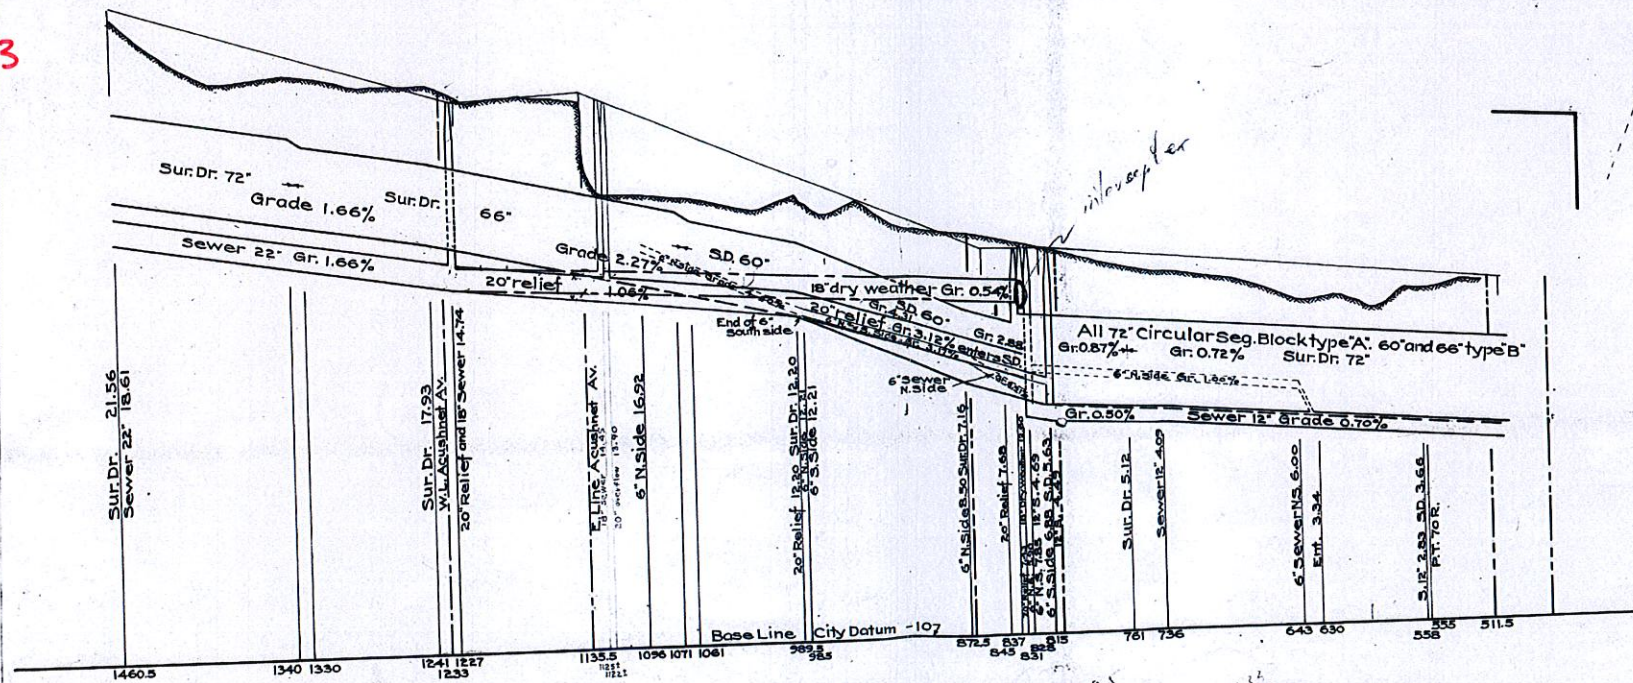

SHEET NO. 2.
TARKILN HILL SYSTEM FIRST SECTION

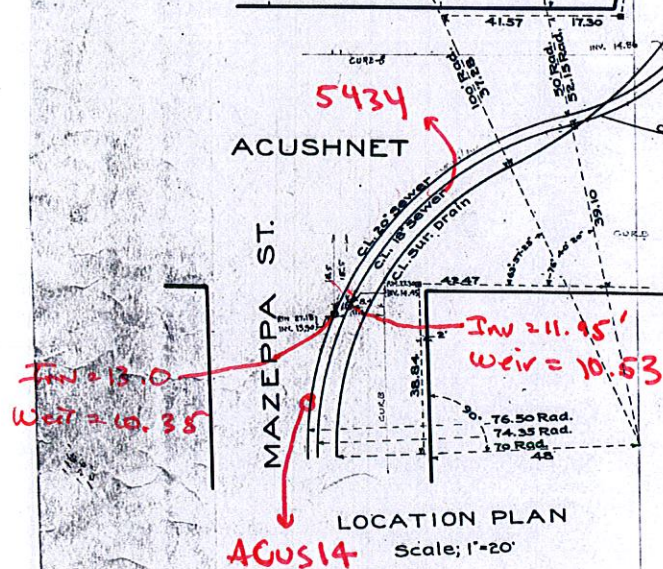

1" = 6' Vert
1227
2330