

CSO SPEC SHEET

Structure #: REG 027 C

Date: 09/ 19 / 2012

Insp. By: AK & AH

Location: At the Intersection of Mill Rd.. and Belleville Ave.

Structure Type: Concrete Weir Wall

Regulator Type: Block Regulator

Structure DIM's: _____

Weir Dim's: _____

Size of Sewer Pipe: ____

Rim to Weir Wall: 9.9'

Size of Storm Drain Pipe: ____

Rim to Storm Drain Invert: _____

Sewer Direction: North to South

Rim to Top of Sewer (Normal Flow): 11.0'

Free Board: 1.1'

Over All Rating: (Circle One)

Poor


Fair

Good

Excellent

Comments: No repairs needed.

Field Sketch:

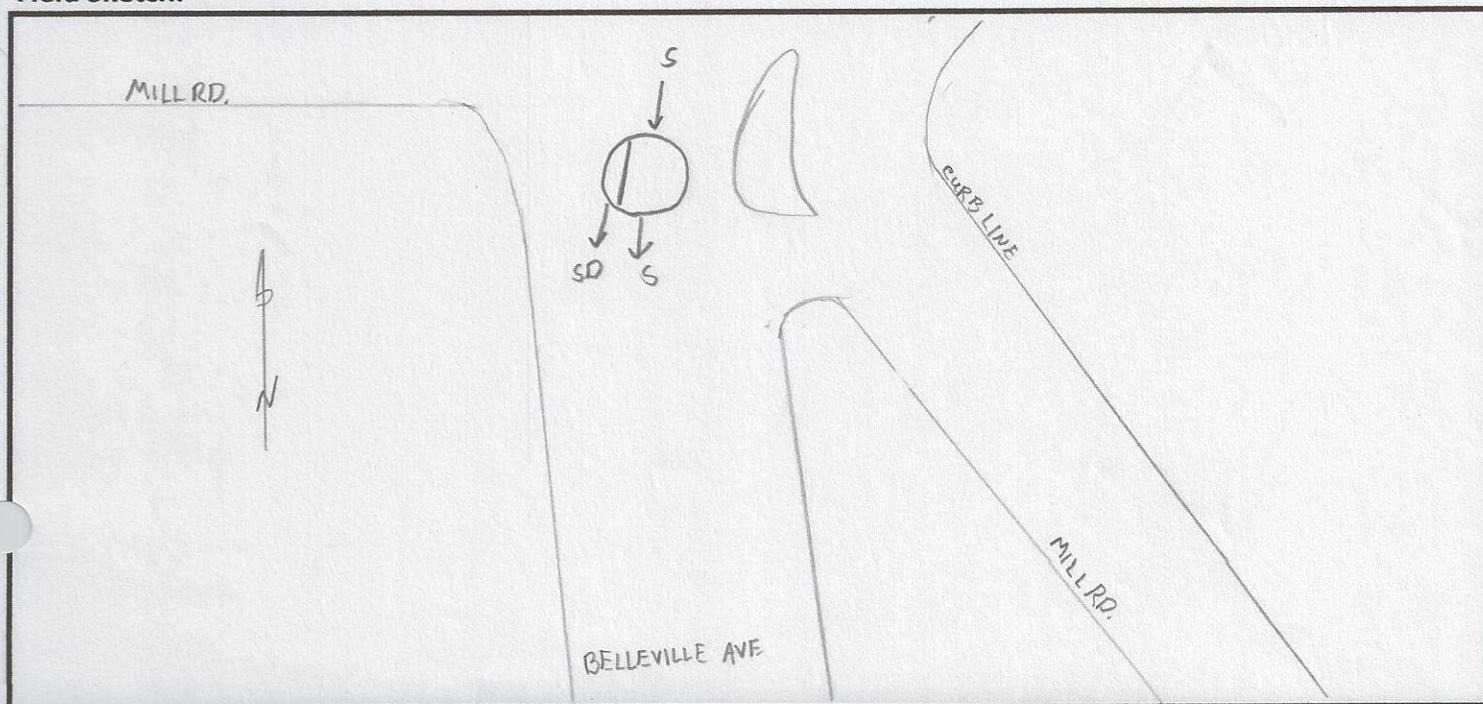

CSO FIELD PHOTOS

Structure#: REG 027 C

Location: At the Intersection of Mill Rd. and Belleville Ave.

Figure 1.



Figure 2.


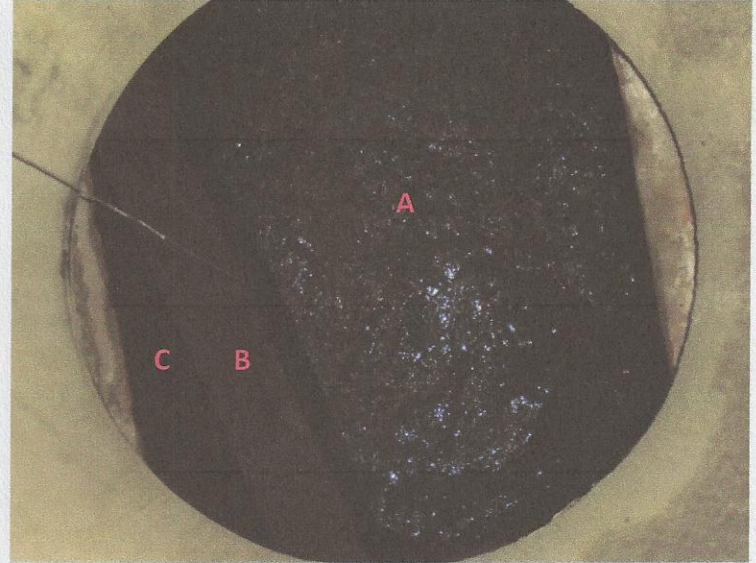


Figure 3.

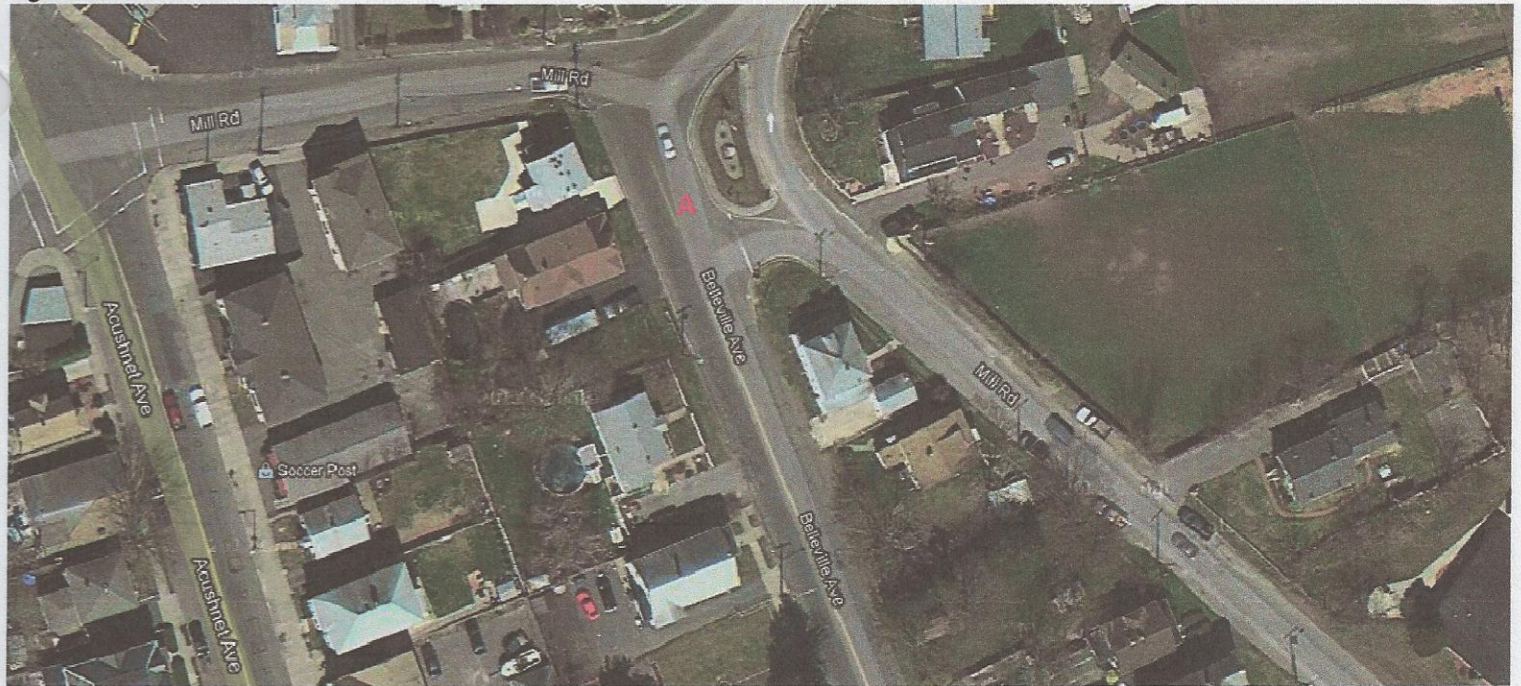


Descriptions

Figure 1: View of Regulator 027 C. Facing North.

Figure 2: Inside view of manhole. A- Sewer; B- Weir Wall; C- Storm Drain.

Figure 3: Google Earth Image of location of Regulator 027 C. A- Reg 027C.

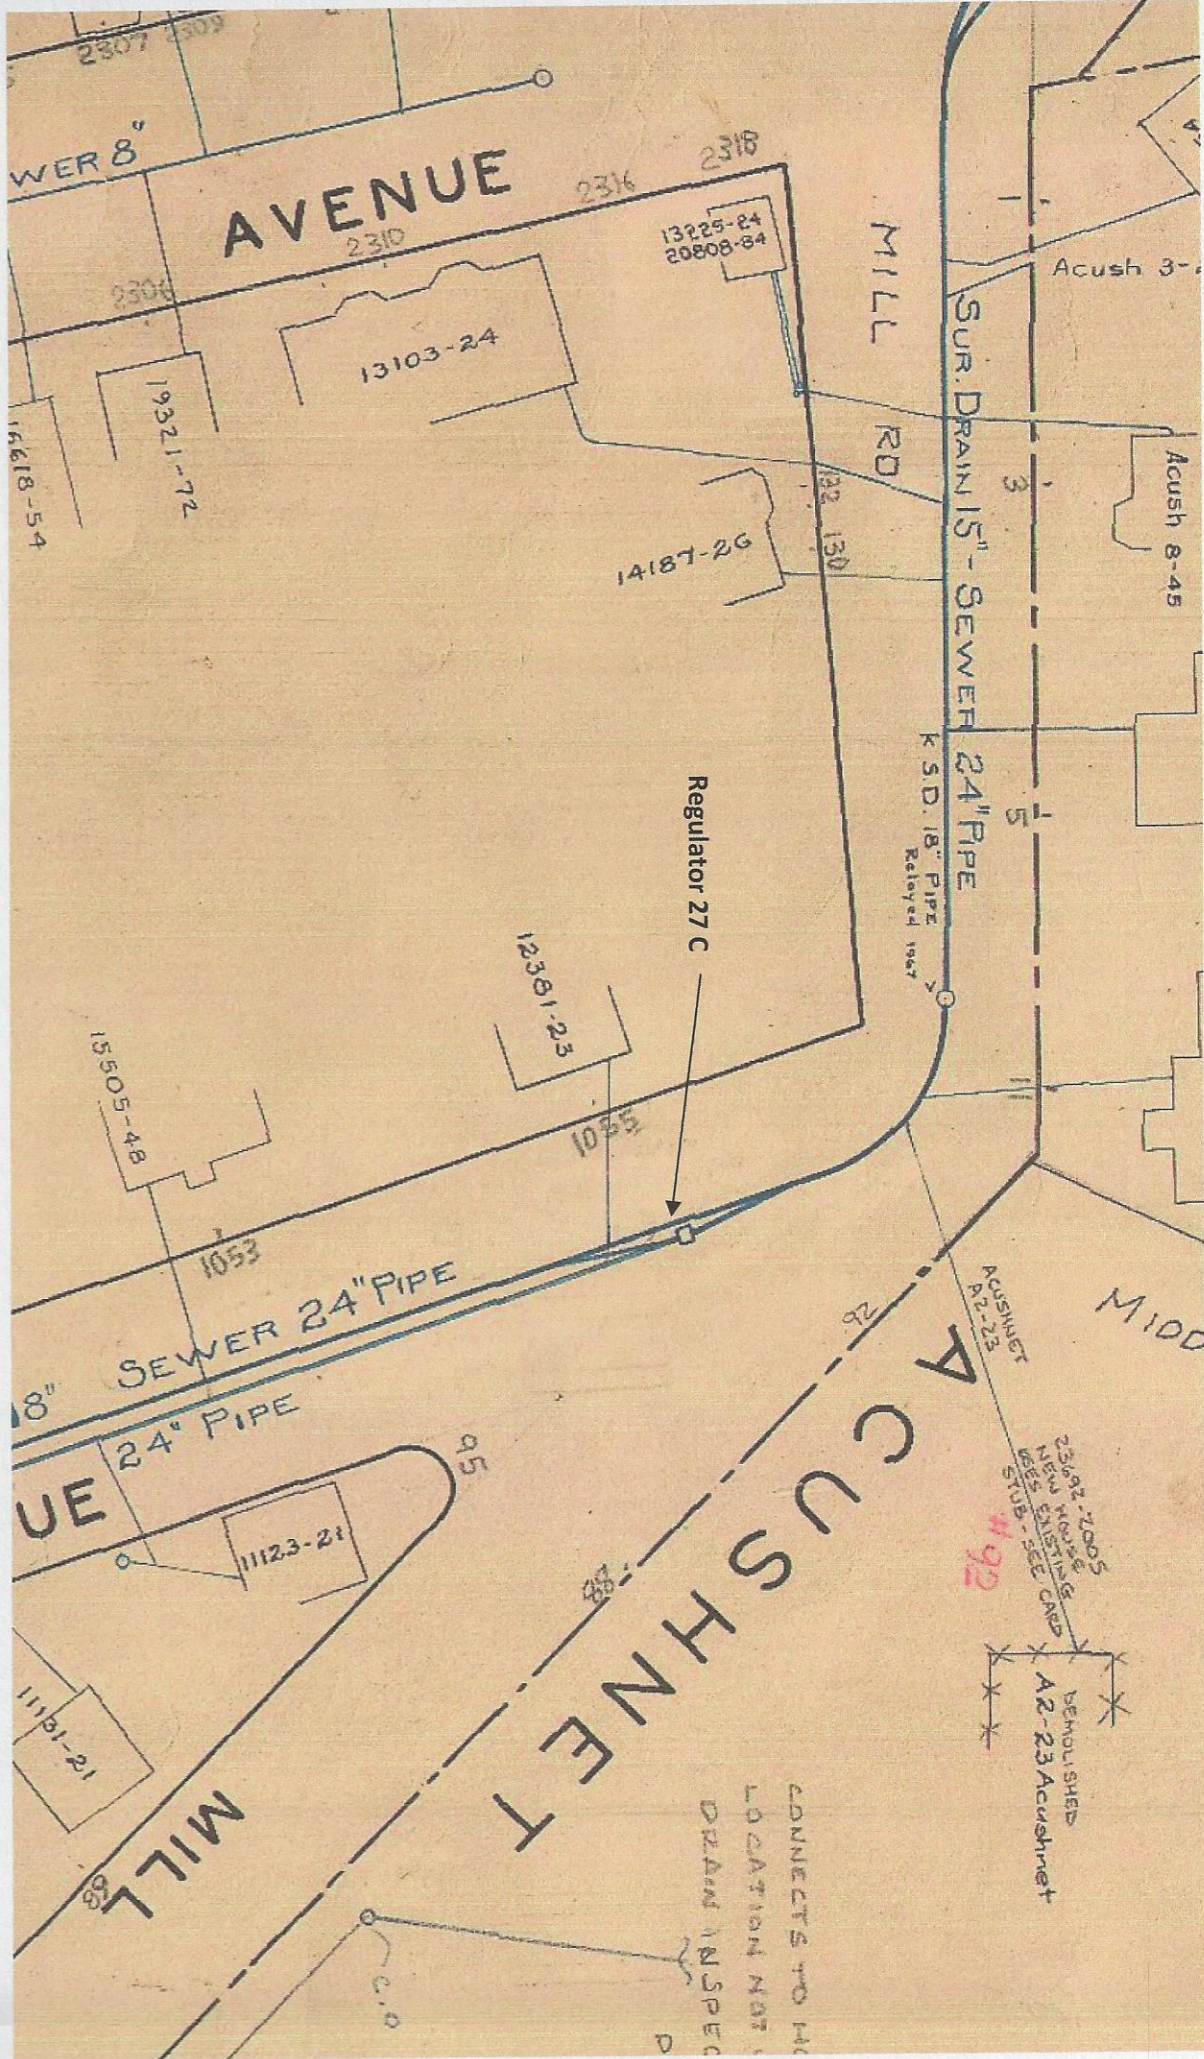

CSO/Regulator Repair Log

Structure #: Reg 027C

[illegible]