



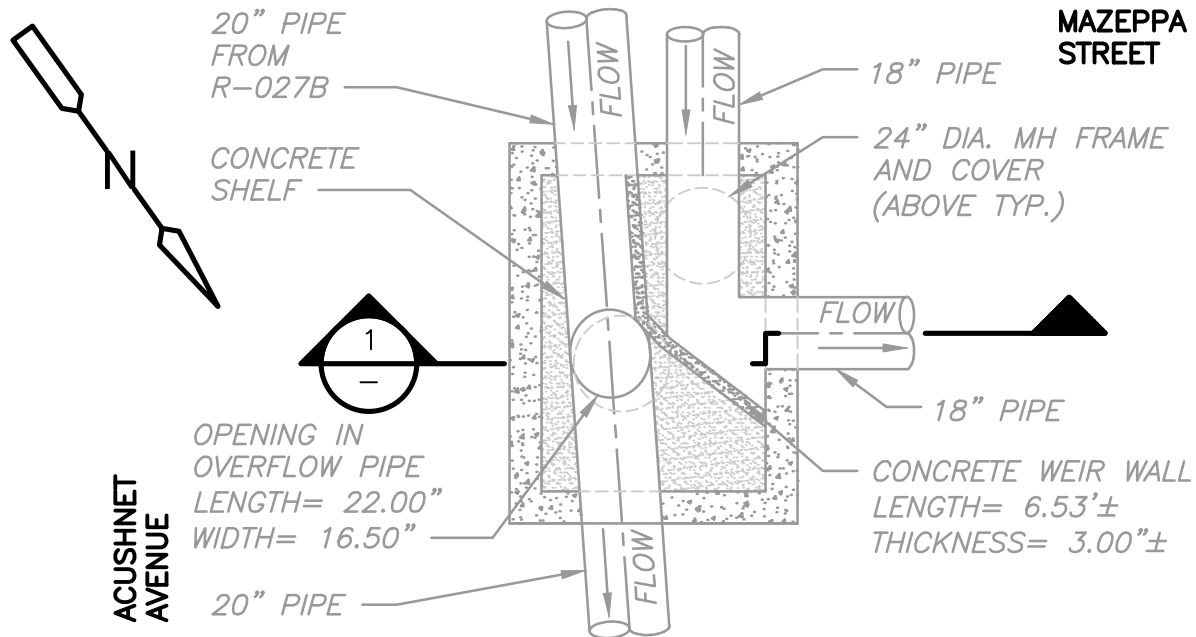

PLAN

1/4" = 1'-0"

NOTE:
ELEVATIONS SHOWN ARE
IN NEW BEDFORD CITY
DATUM.

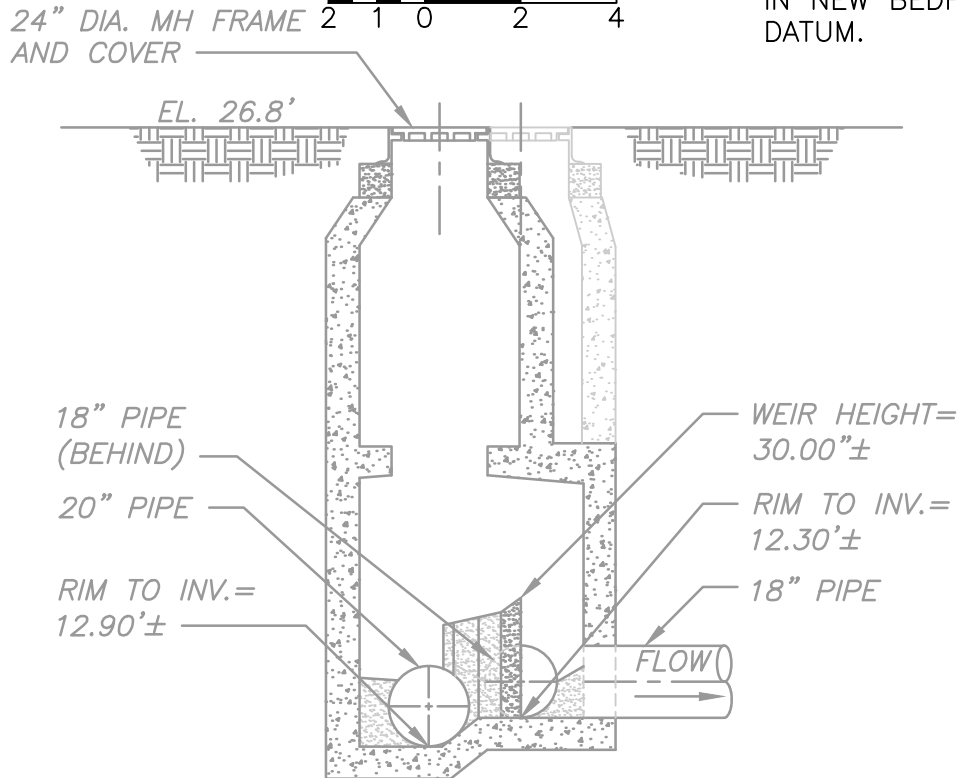

SECTION

1/4" = 1'-0"

