


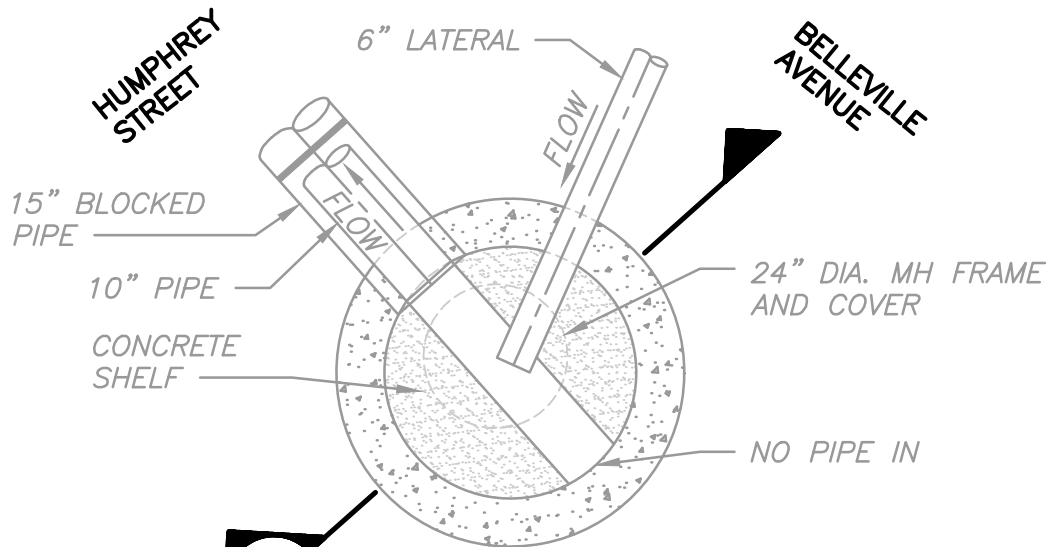


PLAN

$3/8" = 1'-0"$



NOTE:
ELEVATIONS SHOWN ARE IN
NEW BEDFORD CITY DATUM.

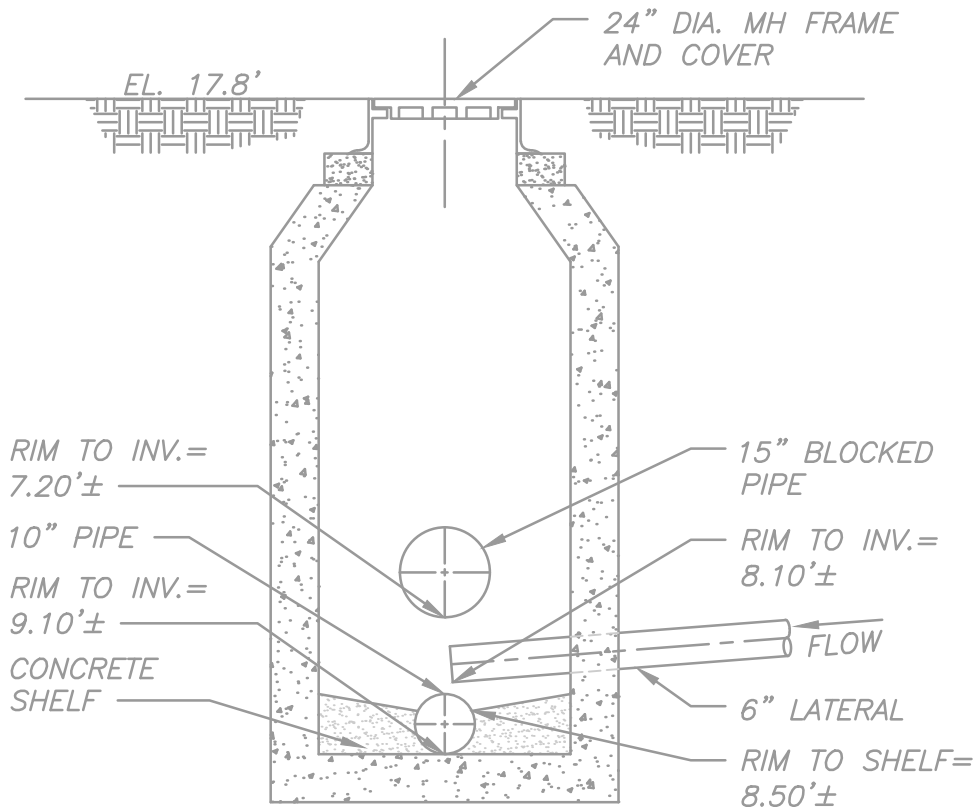

SECTION

$3/8" = 1'-0"$

