

CSO SPEC SHEET

Structure #: REG 030 A

Date: 09/04 / 2012
Insp. By: AK

Location: At the Intersection of Potomska St and Second St.

Structure Type: Poured in Place

Regulator Type: Block Reg

Structure DIM's: _____

Weir Dim's: _____

Size of Sewer Pipe: 30"

Rim to High Level Outfall: 6.1'

Size of Storm Drain Pipe: 30"

Rim to Storm Drain Invert: _____

Sewer Direction: East to South

Rim to Top of Sewer (Normal Flow): 6.5'

Free Board: .4'

Over All Rating: (Circle One)

Poor


Fair

Good

Excellent

Comments: Block is Missing.

Field Sketch:

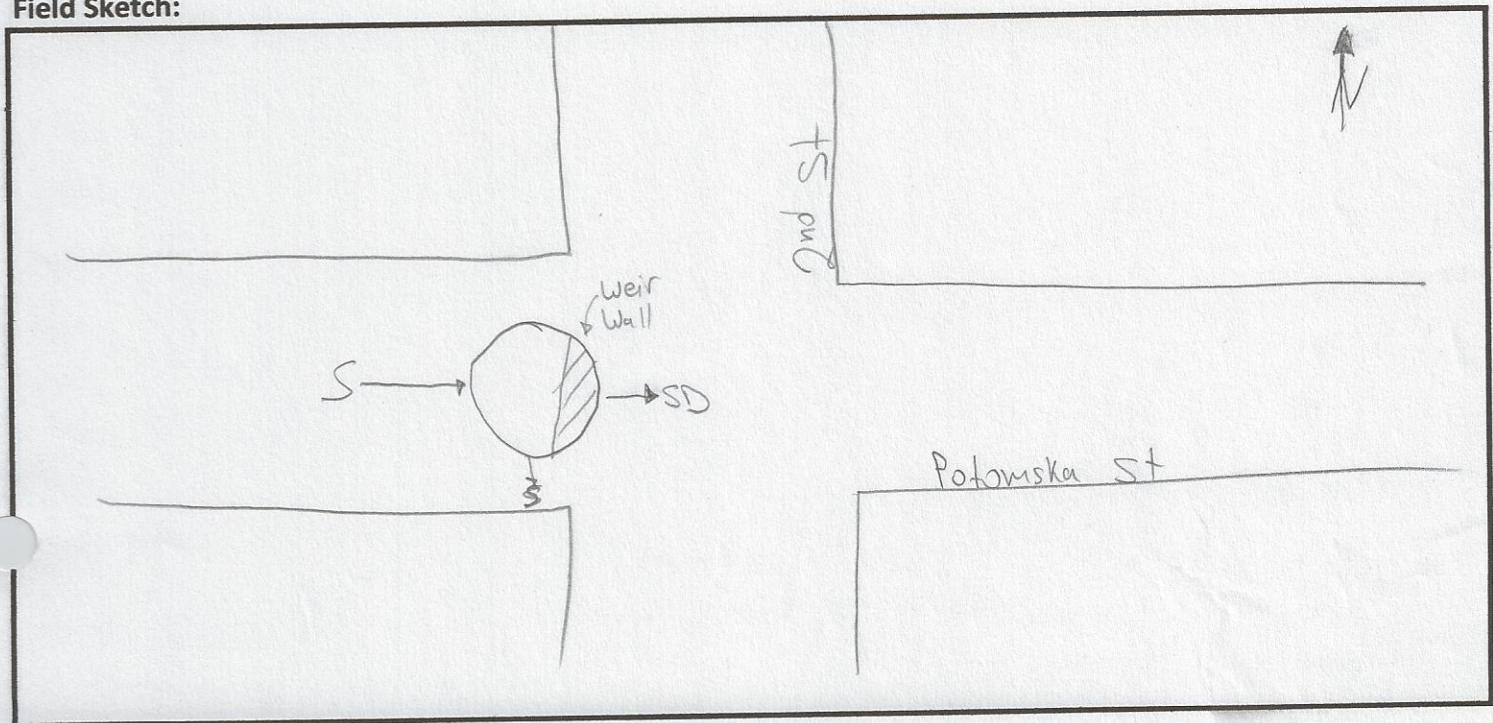

CSO FIELD PHOTOS

Structure#: REG 030 A

Location: At the Intersection of Potomska St and Second St.

Figure 1.



Figure 2.

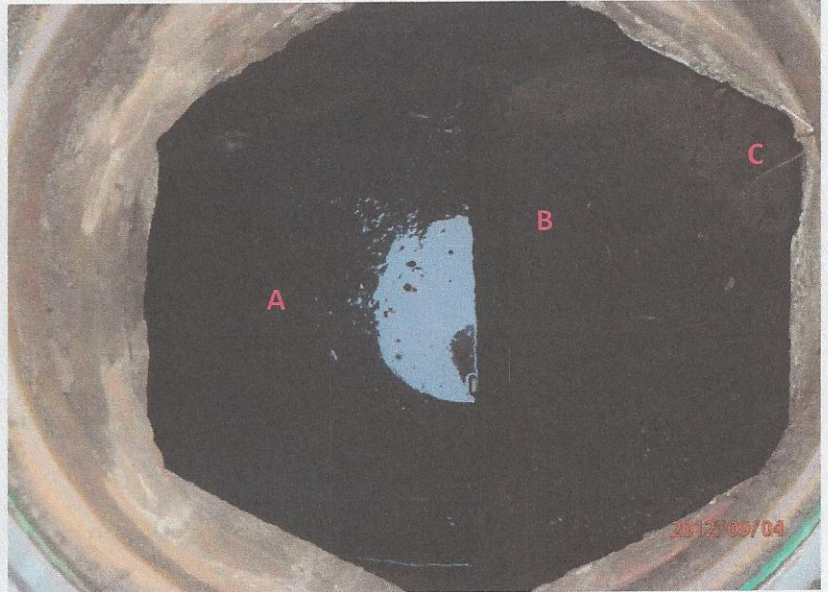


Figure 3.



Figure 4.




Descriptions

Figure 1: View of Regulator 030 A. Facing East.

Figure 2: Inside view of manhole. A- Sewer; B- Weir Wall; C- Storm Drain.

Figure 3: Street view of Regulator 030 A. Facing East.

Figure 4: Google Earth Image of location of Regulator 030 A. A- Reg 030 A

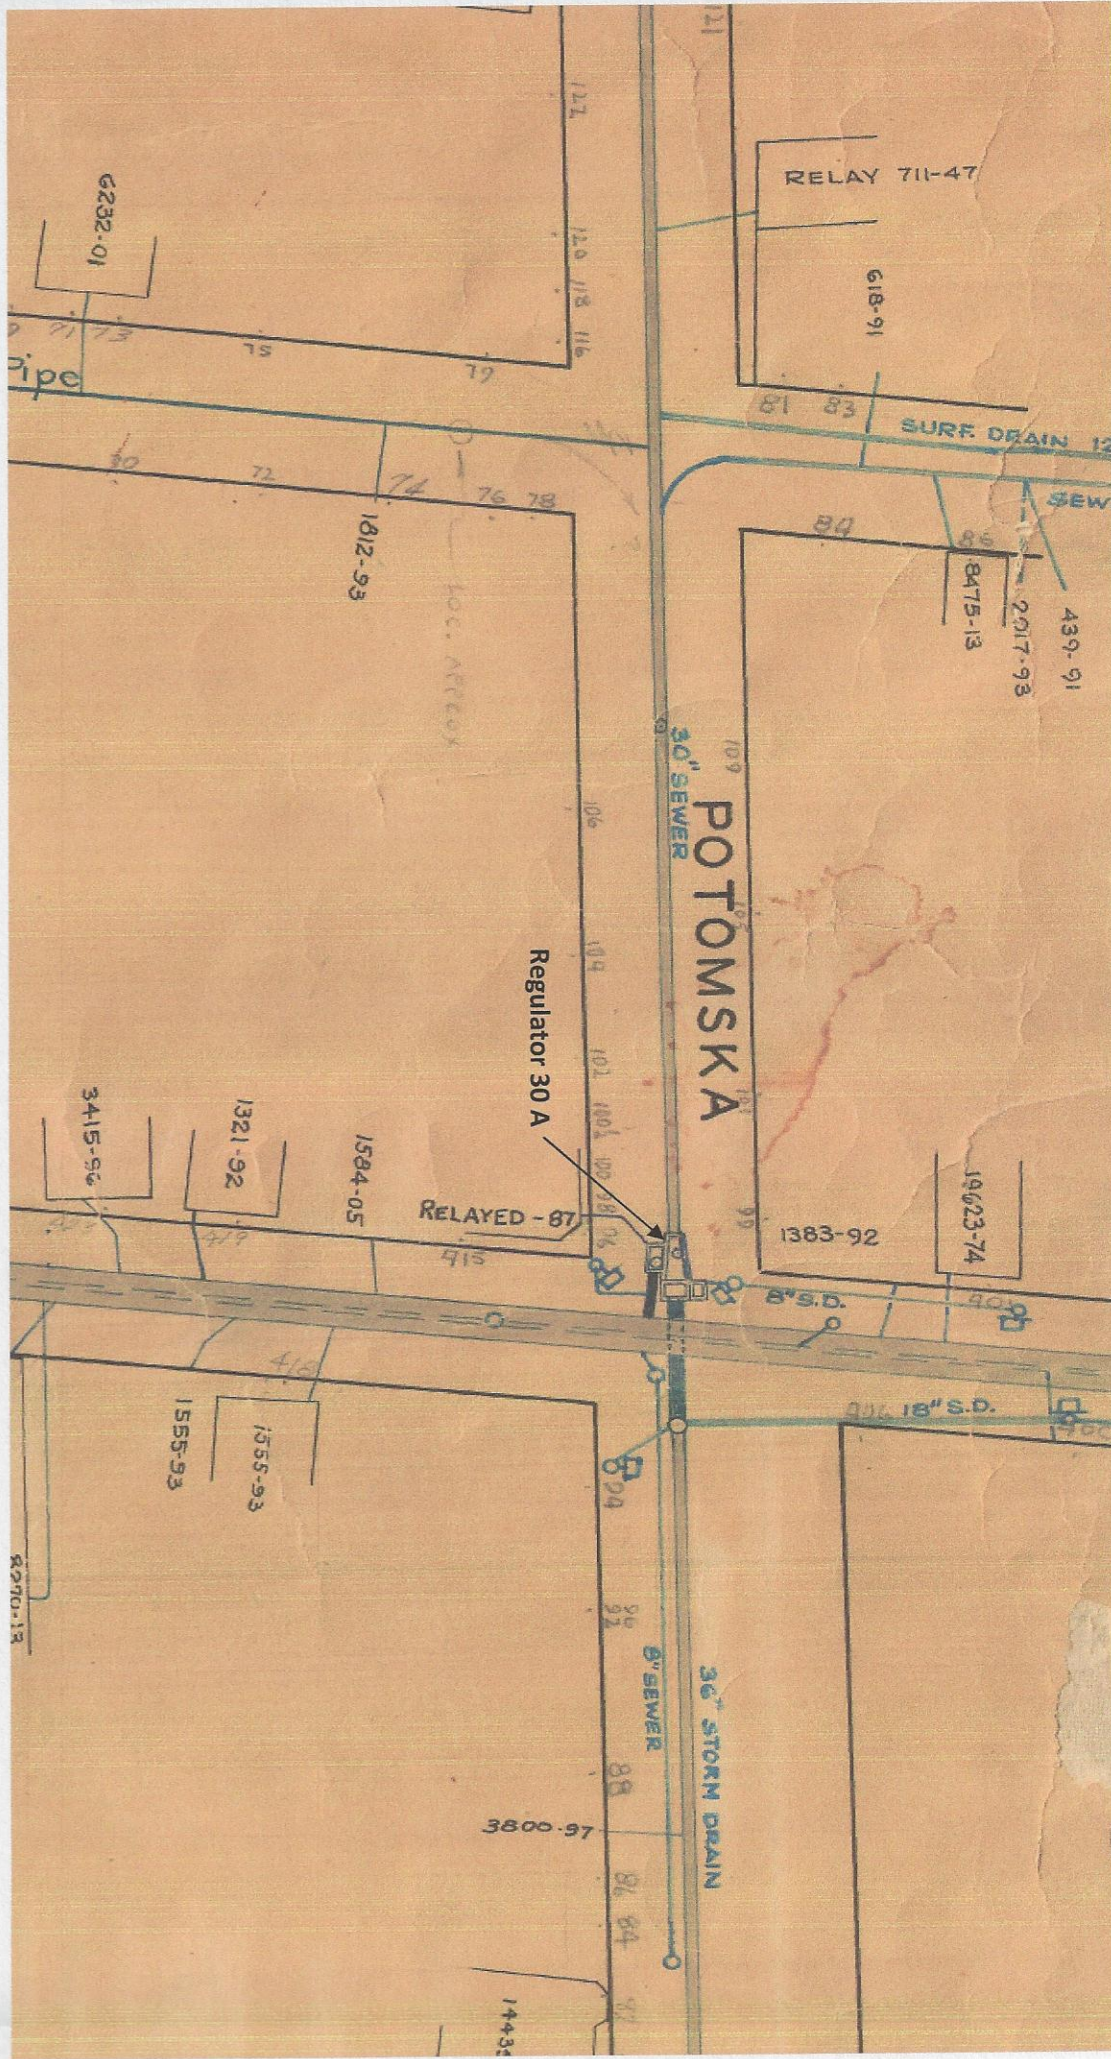

CSO/Regulator Repair Log

Structure #: Reg 030 A

[illegible]