


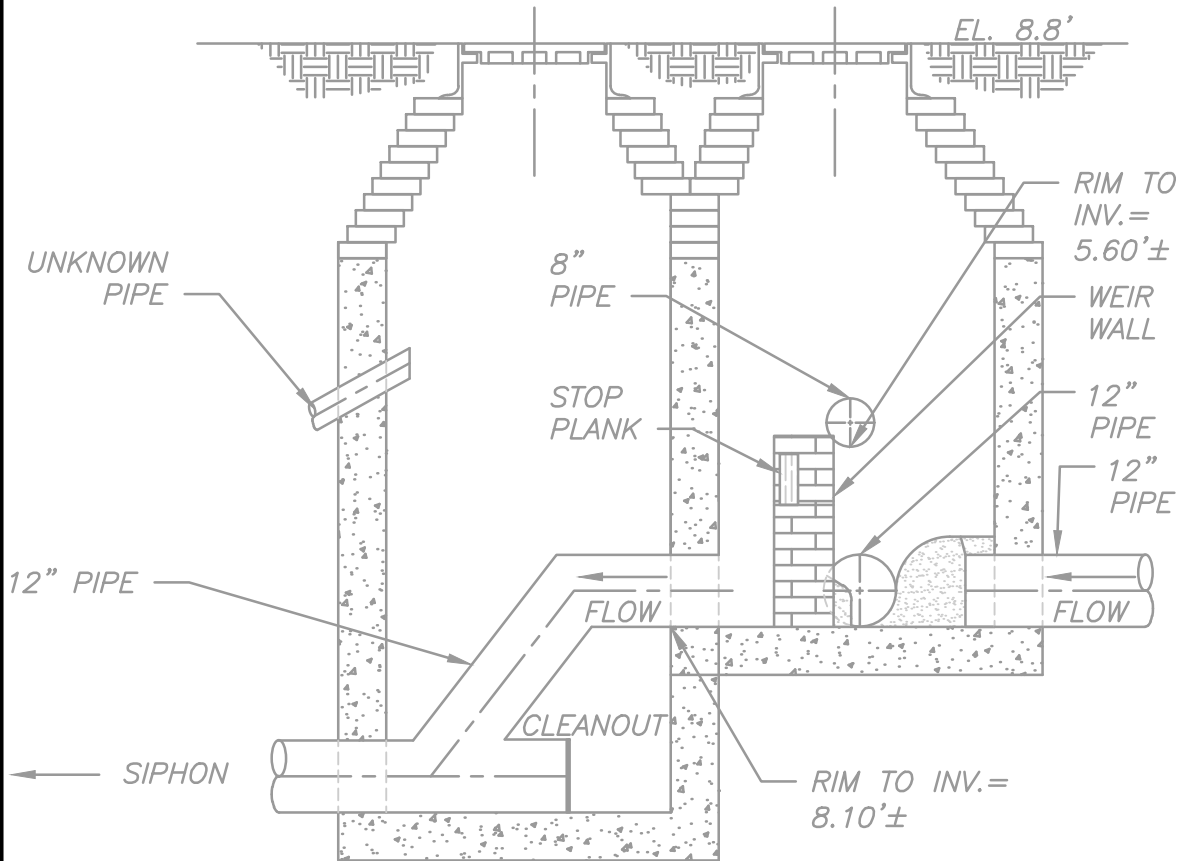


SECTION

$3/8" = 1'-0"$

2

SH.2

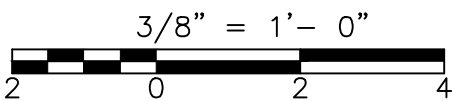

NOTE:

ELEVATIONS SHOWN ARE IN
NEW BEDFORD CITY DATUM.