

CSO SPEC SHEET

Structure #: REG 030 B

Date: 09/04/2012

Insp. By: AK

Location: At the Intersection of South St and Second St.

Structure Type: Slotted Weir.

Regulator Type: Block Reg

Structure DIM's: _____

Weir Dim's: _____

Size of Sewer Pipe: 12"

Rim to High Level Outfall: 6.0'

Size of Storm Drain Pipe: 15"

Rim to Storm Drain Invert: _____

Sewer Direction: East to South

Rim to Top of Sewer (Normal Flow): 8.1'

Free Board: 2.1'

Over All Rating: (Circle One)

Poor


Fair

Good

Excellent

Comments: No Repairs Needed.

Field Sketch:

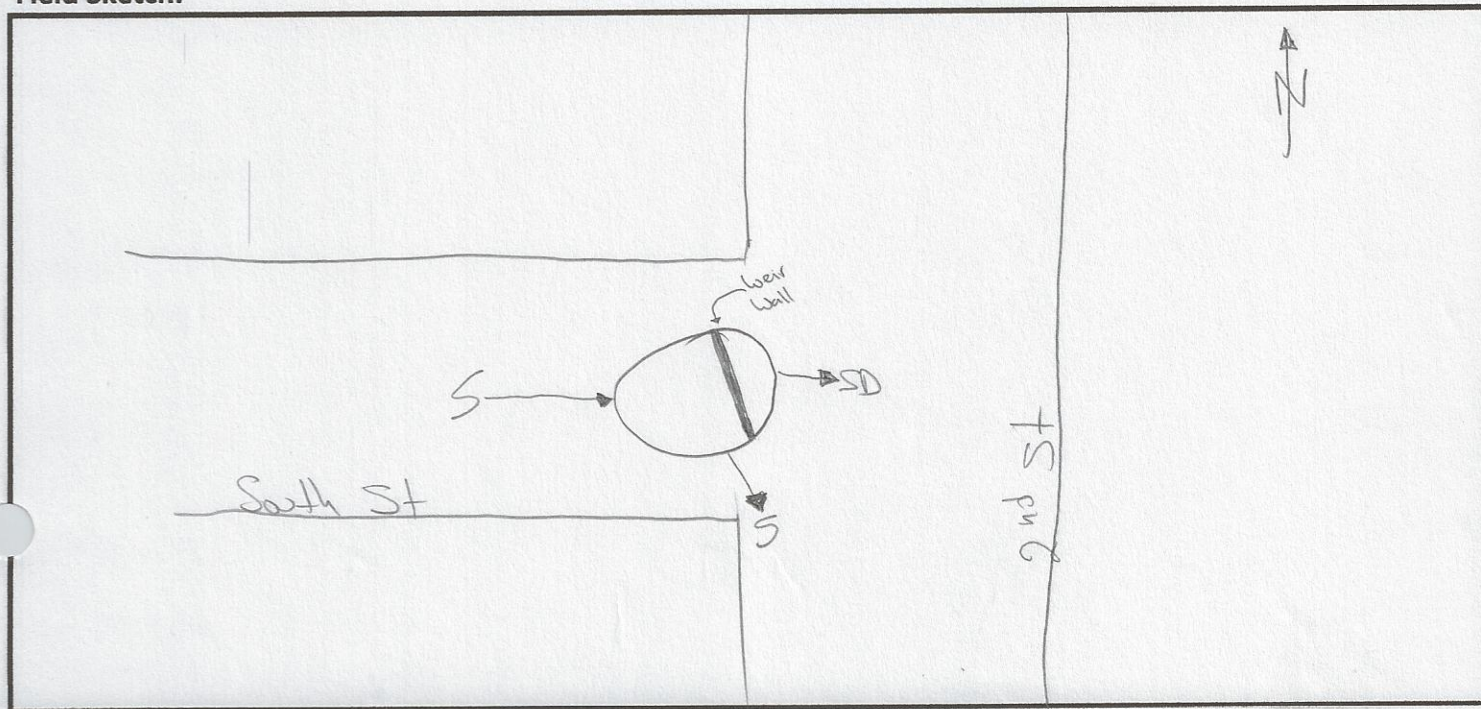

CSO FIELD PHOTOS

Structure#: REG 030 B

Location: At the Intersection of South St and Second St.

Figure 1.



Figure 2.

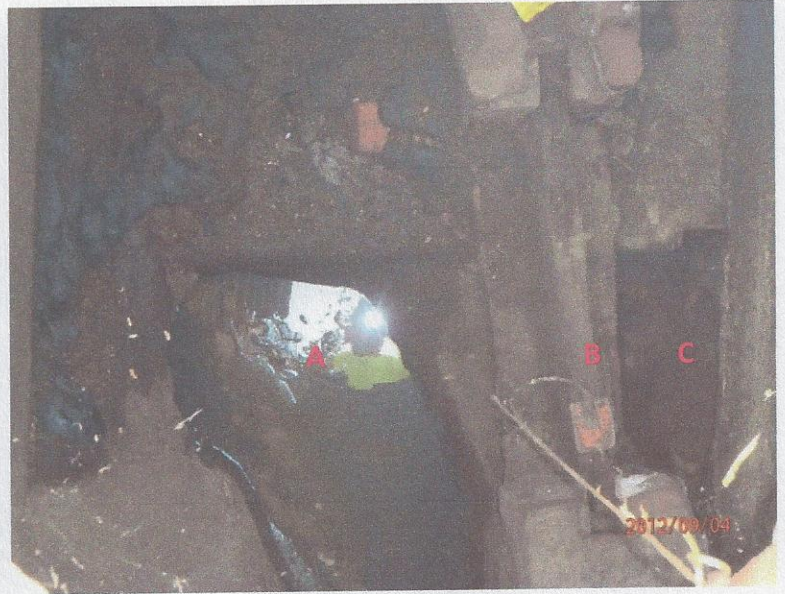


Figure 3.




Descriptions

Figure 1: View of Regulator 030 B. Facing East.

Figure 2: Inside view of manhole. A- Sewer; B- Weir Wall; C- Storm Drain.

Figure 3: Google Earth Image of location of Regulator 030 B. A- Reg 030 B

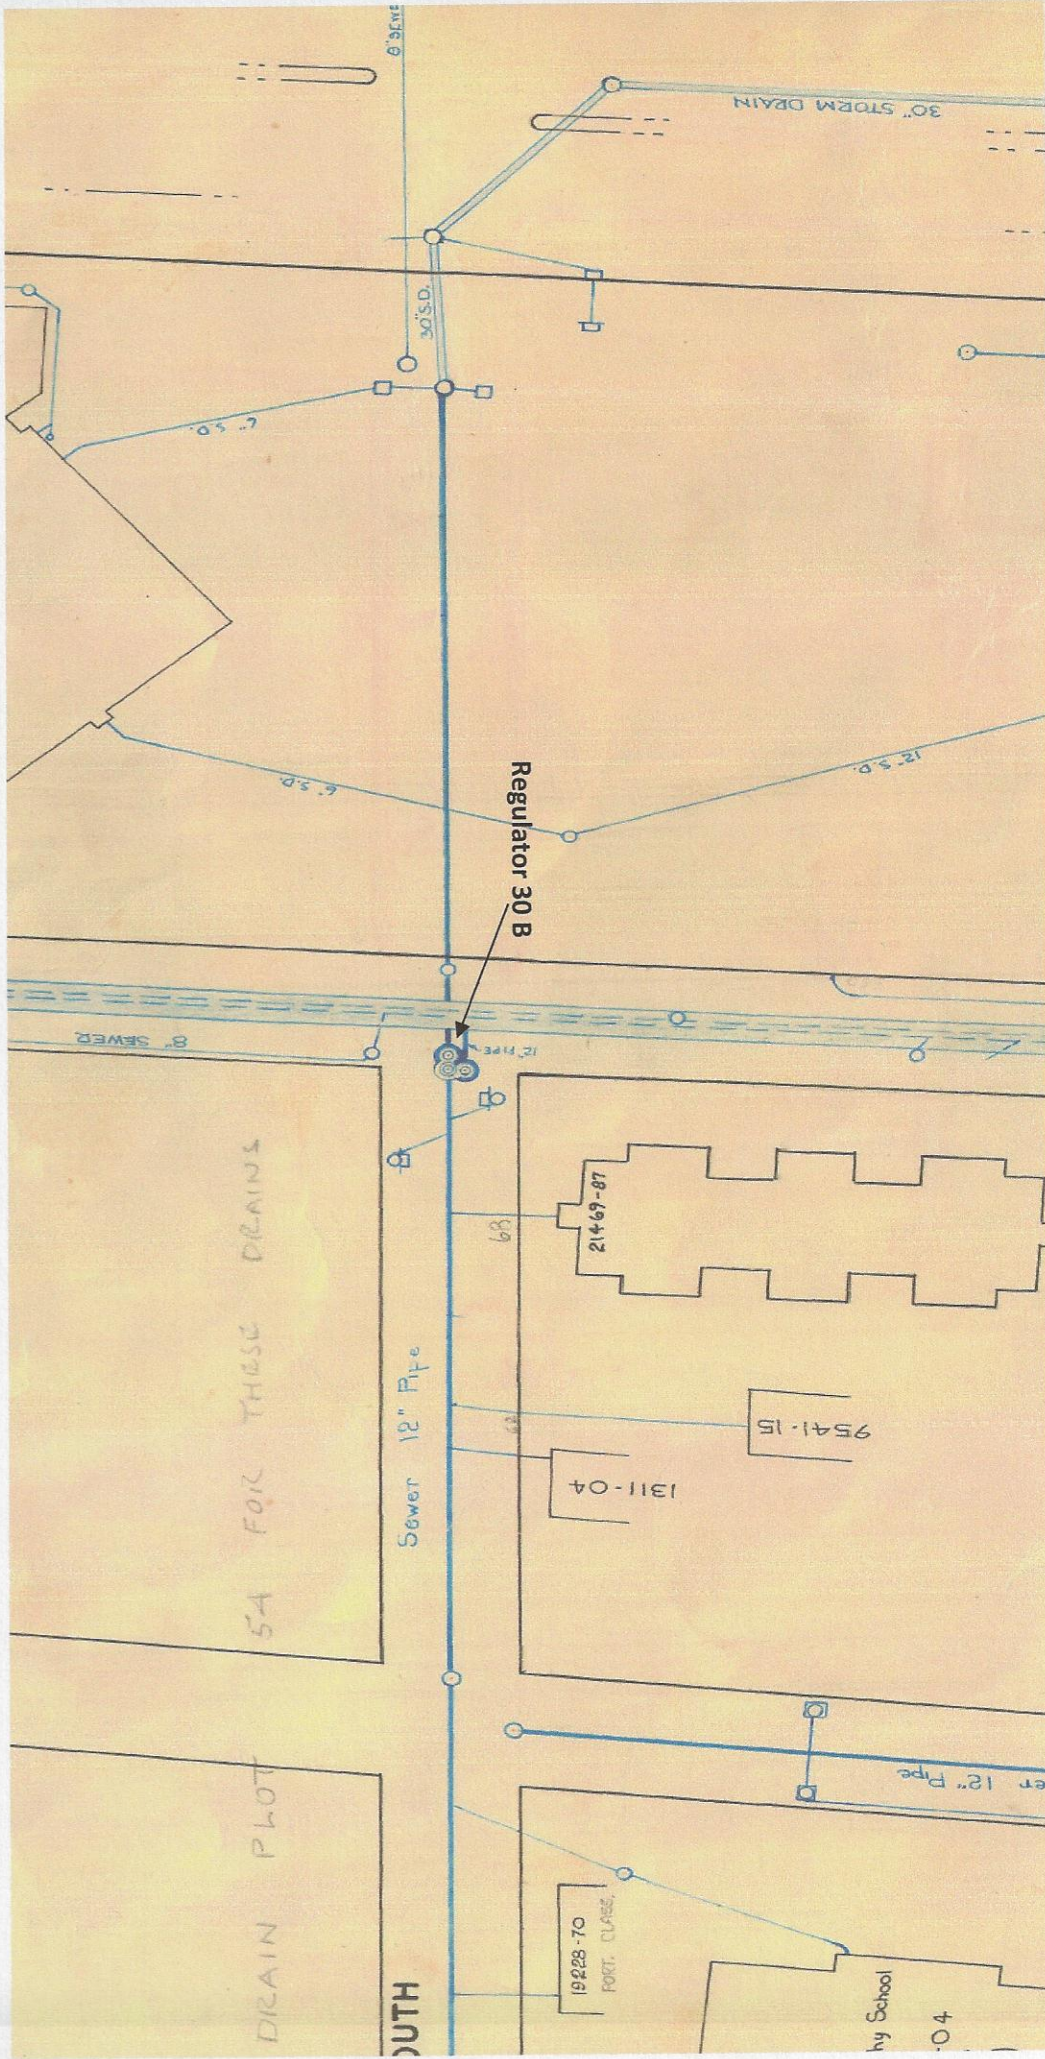

Regulator 30 B

Sewer 12" Pipe

8" SEWER

30" STORM DRAIN

5A FOR THESE DRAINS

DRAIN PLOT

21469-87

9541-15

1311-04

19228-70
PORT. CLASH.

hy School
-04

12" S.D.

6" S.D.

30" S.D.

6" S.D.

CSO/Regulator Repair Log

Structure #: Reg 030 B

[illegible]