

CSO SPEC SHEET

Structure #: REG 031 A

Date: 09/04/2012
Insp. By: AK

Location: At the Intersection of Grinnel St and Second St.

Structure Type: Cast in Place

Regulator Type: Block Reg

Structure DIM's: _____

Weir Dim's: _____

Size of Sewer Pipe: 10"

Rim to High Level Outfall: 6.2'

Size of Storm Drain Pipe: 24"

Rim to Storm Drain Invert: _____

Sewer Direction: East to South

Rim to Top of Sewer (Normal Flow): 6.5'

Free Board: 0.3'

Over All Rating: (Circle One)

Poor


Fair

Good

Excellent

Comments: No Repairs Needed.

Field Sketch:

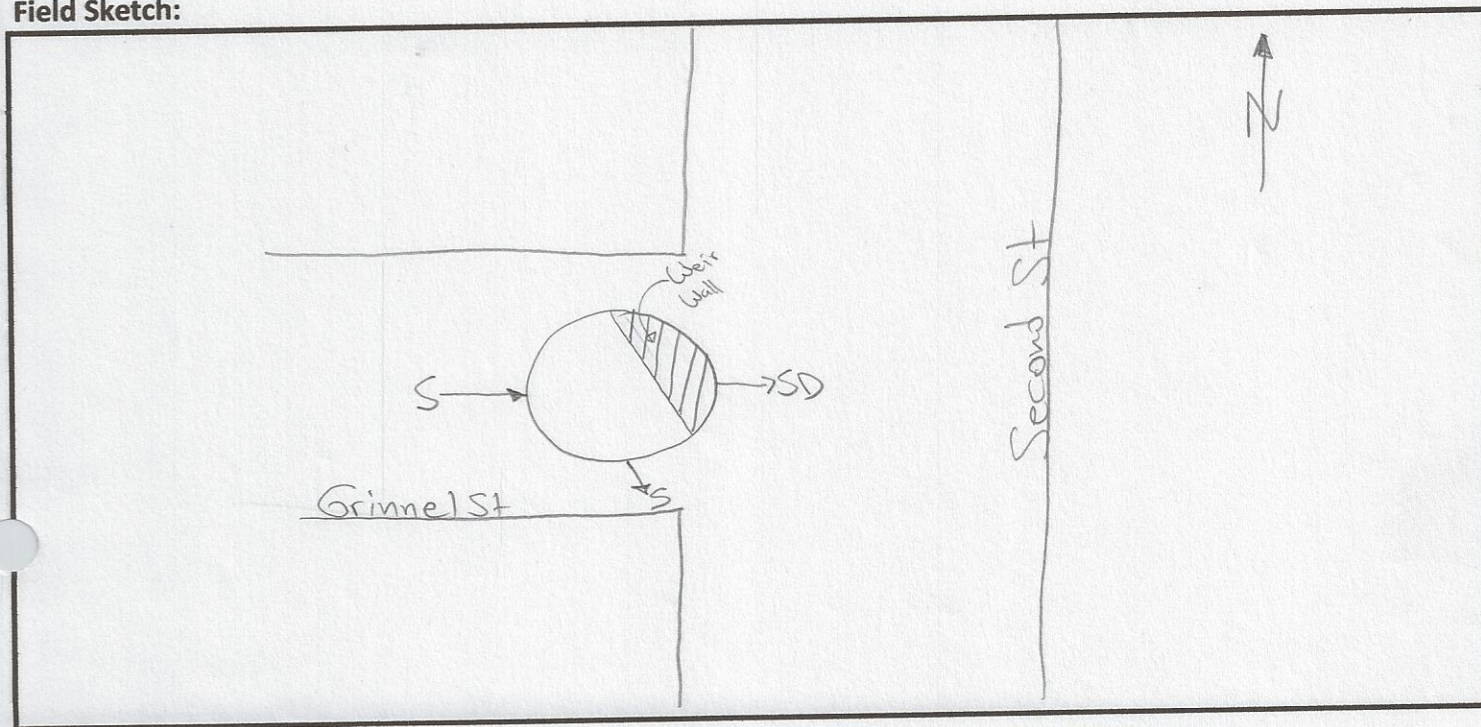

CSO FIELD PHOTOS

Structure#: REG 031 A

Location: At the Intersection of Grinnell St and Second St.


Figure 1.



Figure 2.



Figure 3.

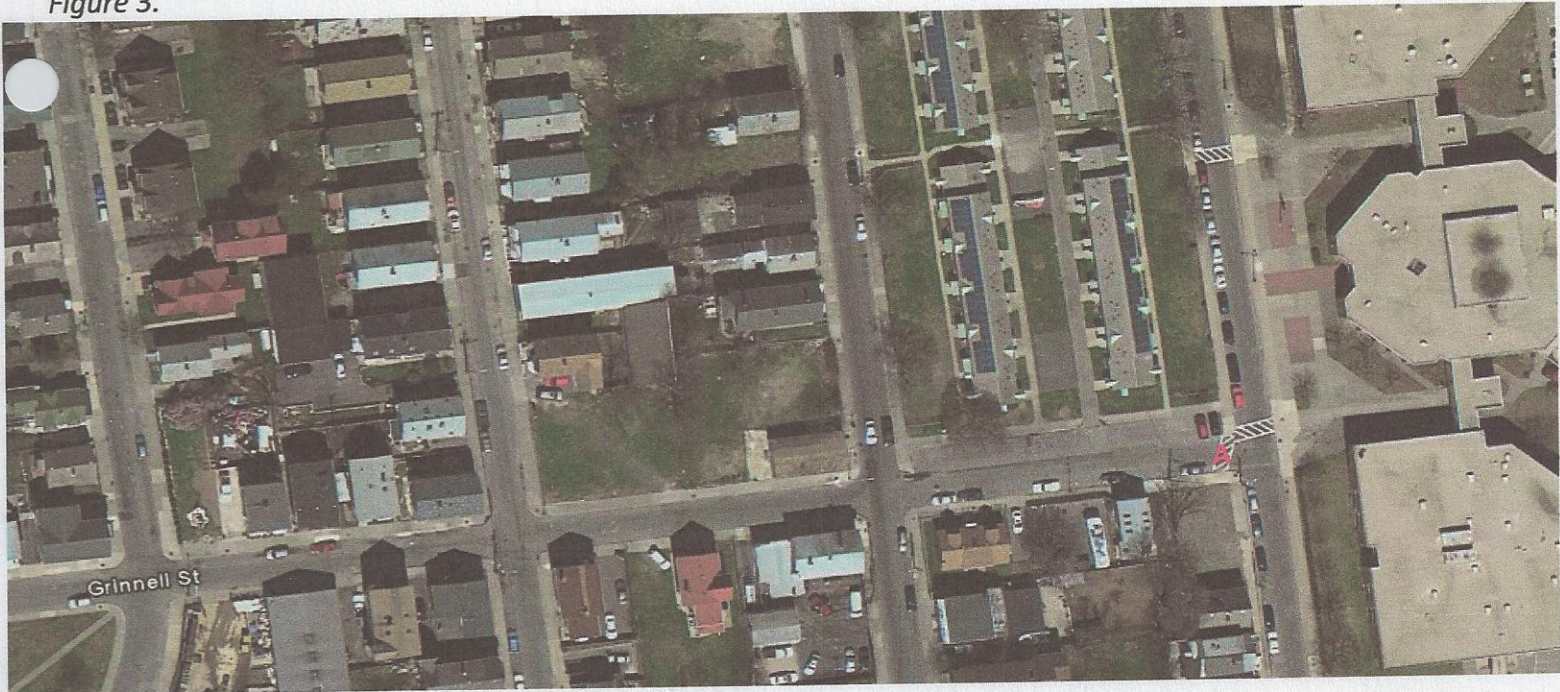


Descriptions

Figure 1: View of Regulator 031 A. Facing East.

Figure 2: Inside view of manhole. A- Sewer; B- Weir Wall; C- Storm Drain.

Figure 3: Google Earth Image of location of Regulator 031 A. A- Reg 031 A

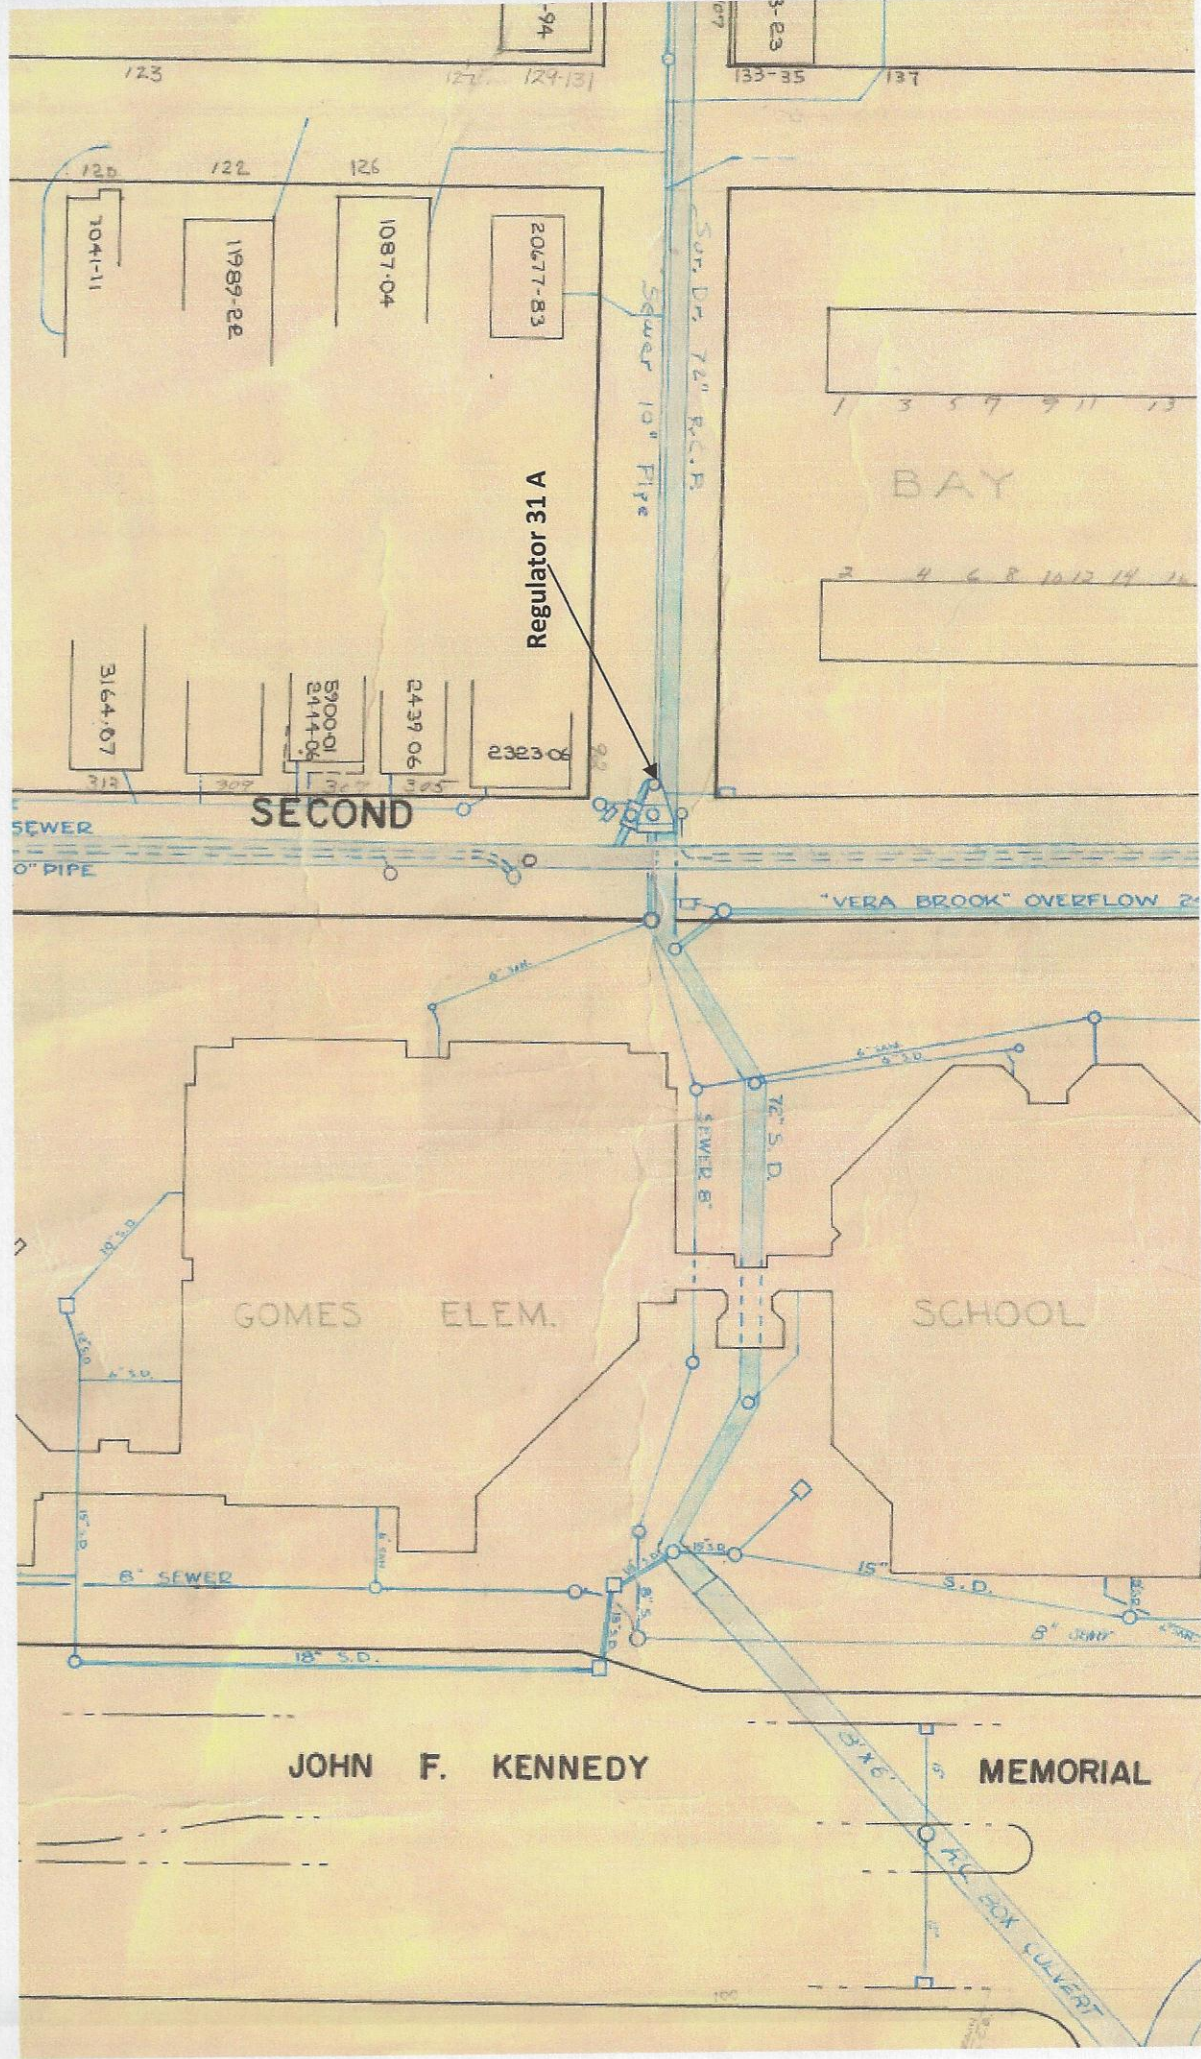

CSO/Regulator Repair Log

Structure #: Reg 031A

[illegible]