

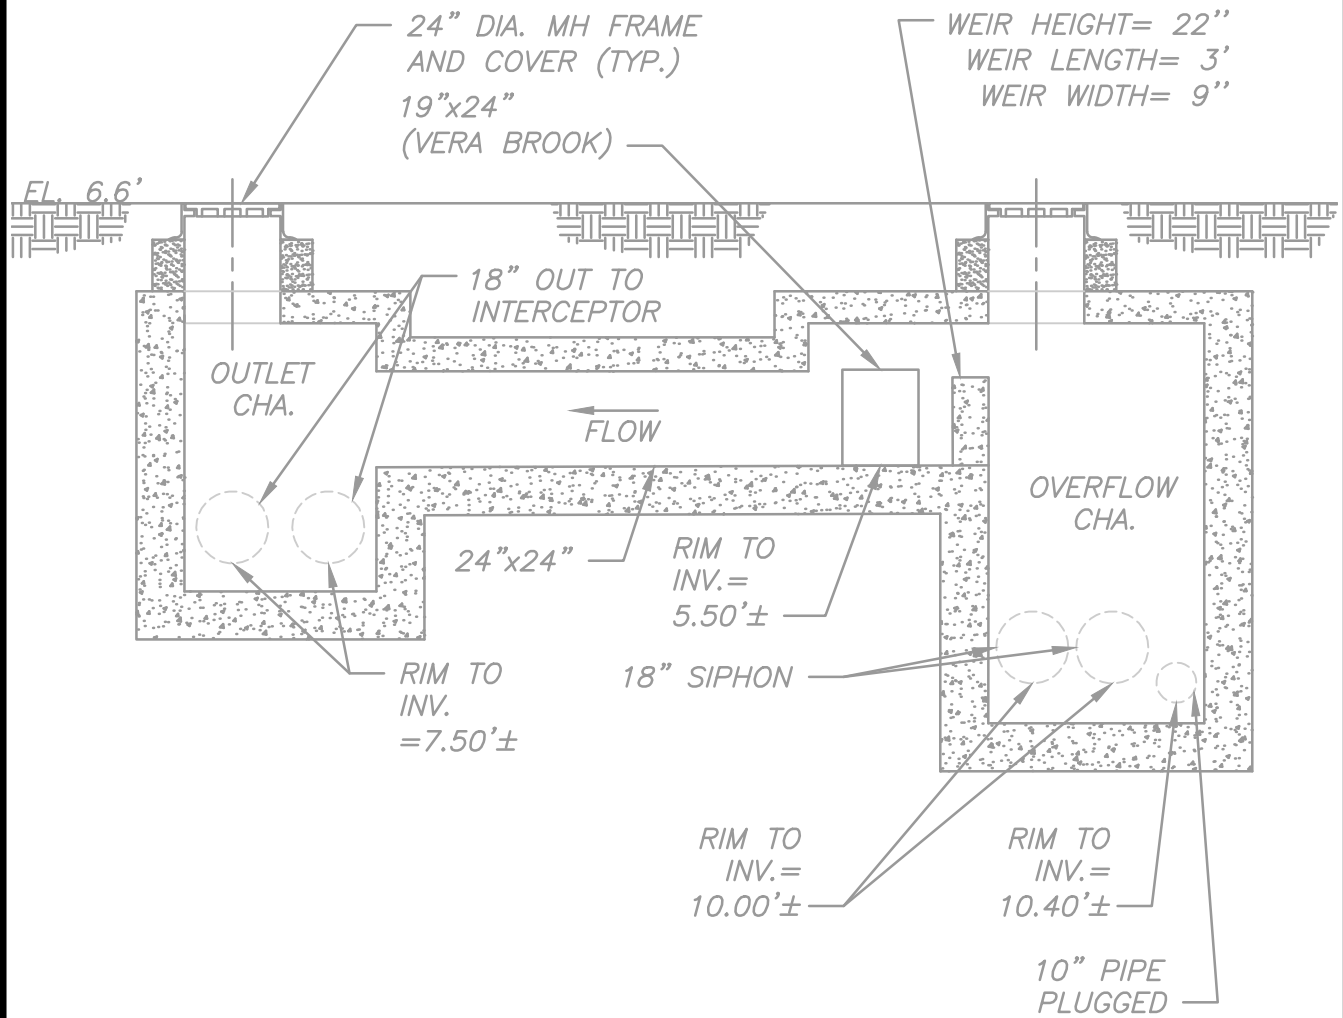


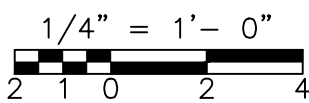

SECTION

1/4" = 1'-0"

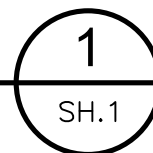

NOTES:

1. ELEVATIONS SHOWN ARE IN NEW BEDFORD CITY DATUM.
2. NO TIDE GATE.
3. BLANK FLANGE ON 10' OUTLET.