

CSO SPEC SHEET

Structure #: REG 031 B

Date: 09/04/2012

Insp. By: AK

Location: At the Intersection of Vera Brook and Second St.

Structure Type: Cast in Place

Regulator Type: Block Reg

Structure DIM's: _____

Weir Dim's: _____

Size of Sewer Pipe: 36"

Rim to High Level Outfall: 3.8'

Size of Storm Drain Pipe: 36"

Rim to Storm Drain Invert: _____

Sewer Direction: East to South

Rim to Top of Sewer (Normal Flow): 6.5'

Free Board: 2.7'

Over All Rating: (Circle One)

Poor


Fair

Good

Excellent

Comments: No Repairs Needed.

Field Sketch:

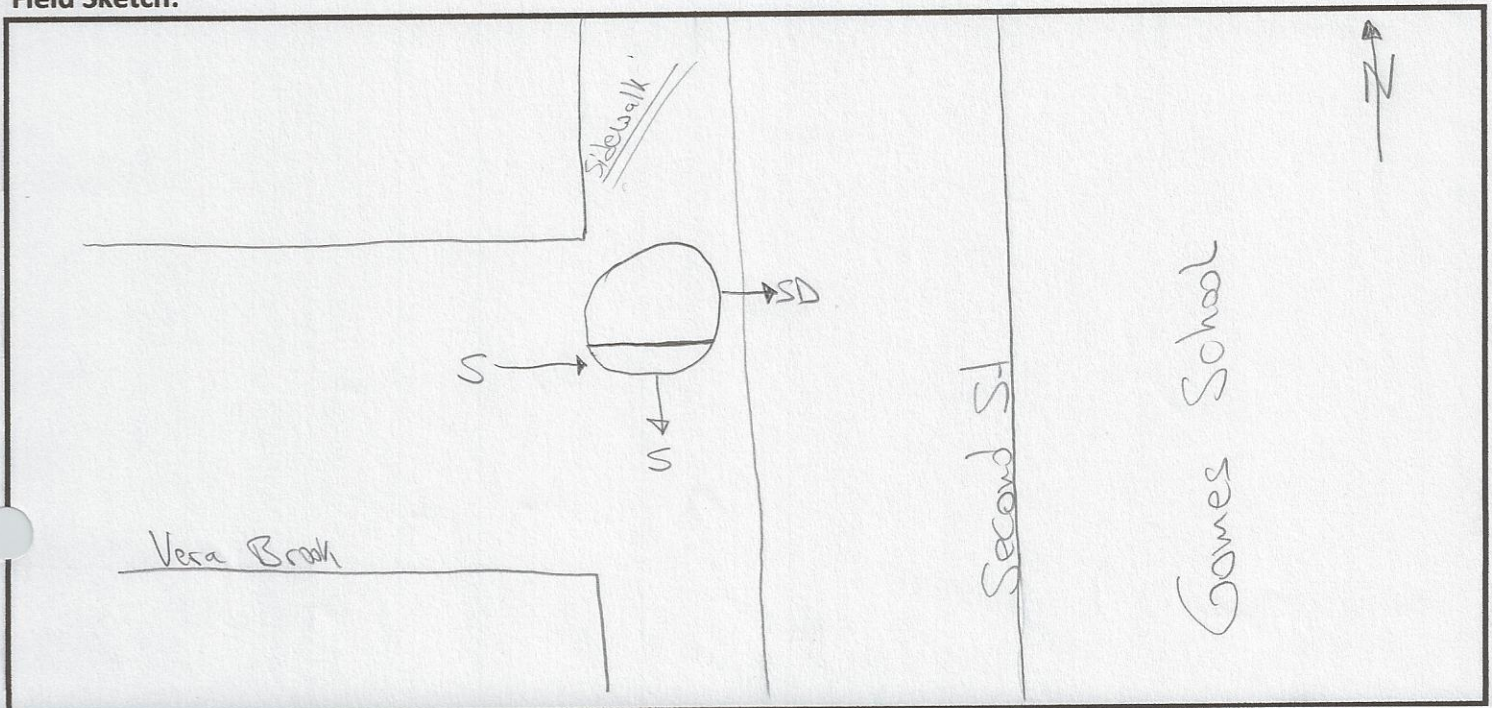

CSO FIELD PHOTOS

Structure#: REG 031 B

Location: At the Intersection of Vera Brook and Second St.


Figure 1.



Figure 2.



Figure 3.

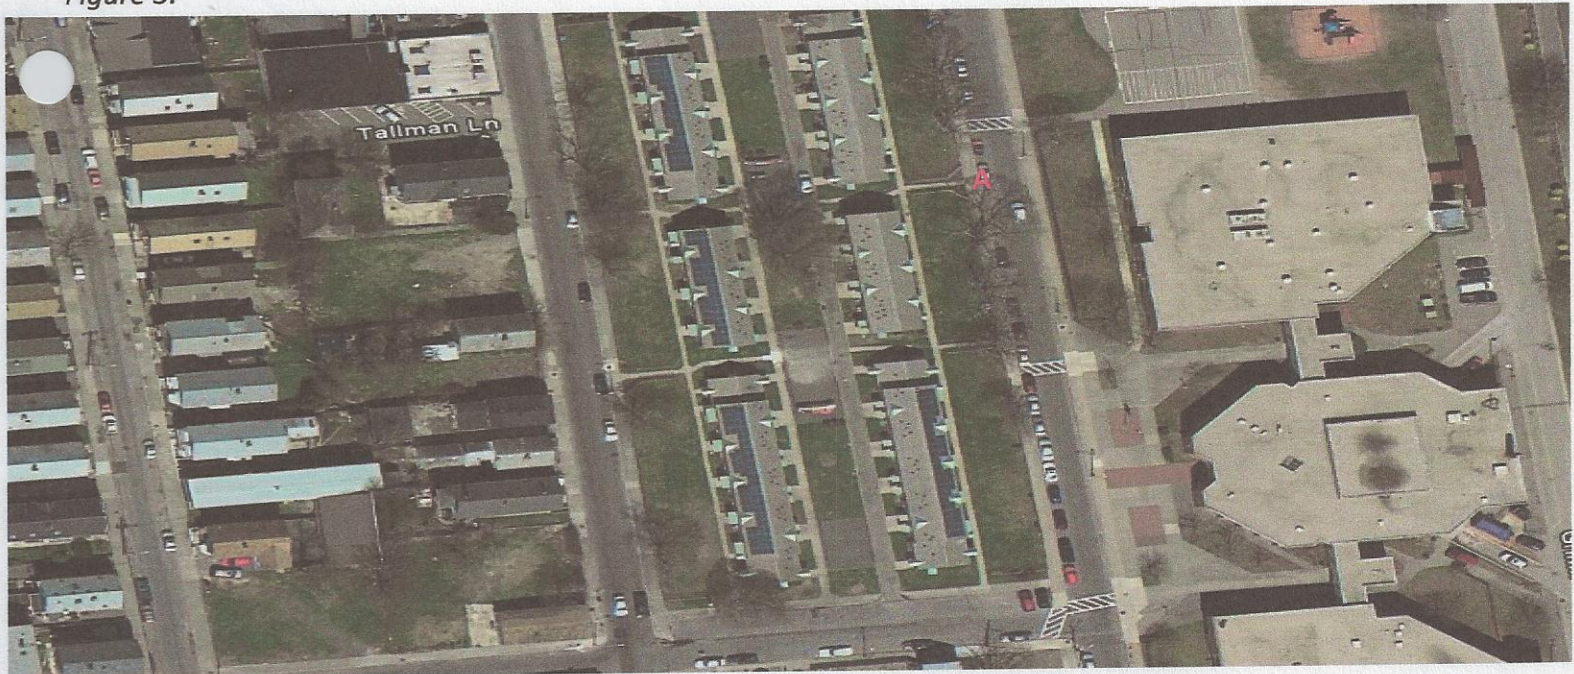

Descriptions

Figure 1: View of Regulator 031 B. Facing North.

Figure 2: Inside view of manhole. A- Sewer; B- Weir Wall; C- Storm Drain.

Figure 3: Google Earth Image of location of Regulator 031 B. A- Reg 031 B

143 AVENUE

149

1100m 540s 1100s

OVERHEAD
STONE
CULVERT

19" x 24" PIPE

Regulator 31 B

24" PIPE

2-18" PIPES

10" PIPE

2-18" PIPES

15" UNDERSEWER

STREET

LOOK" OVERFLOW 24" PIPE

24" PIPE

CSO/Regulator Repair Log

Structure #: Reg 031B

[illegible]