



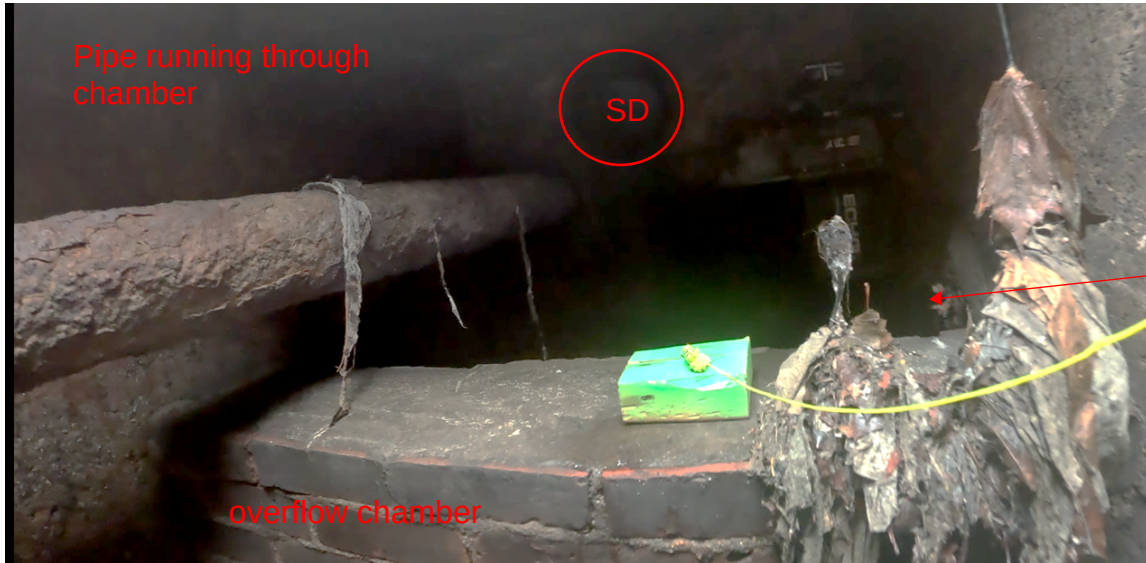

Rim to weir:

Field visit: 3.67'

Redone:

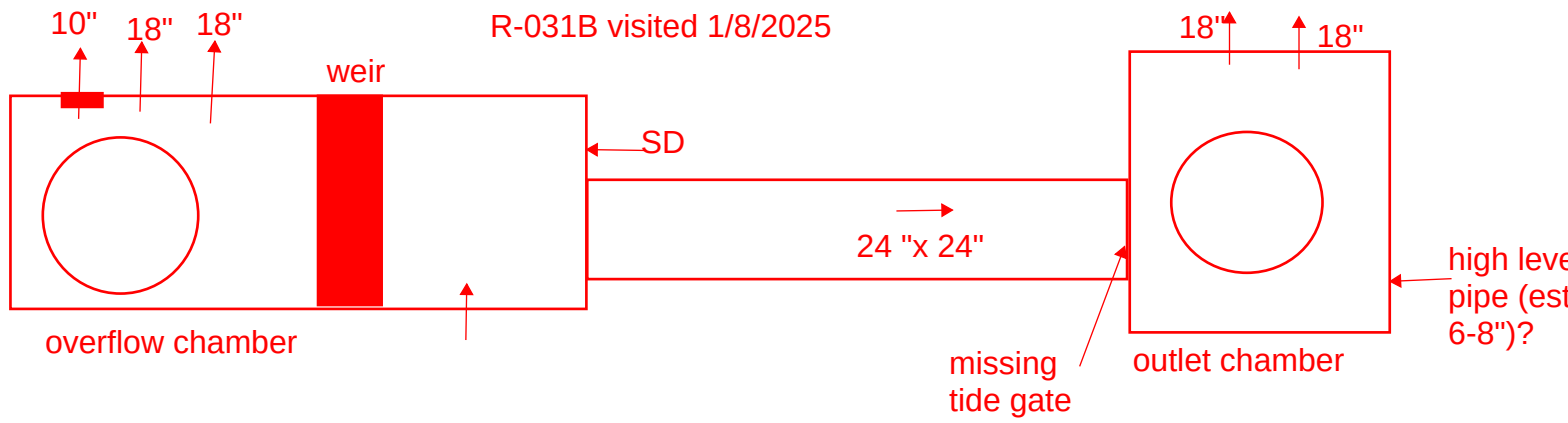



