




MADISON STREET

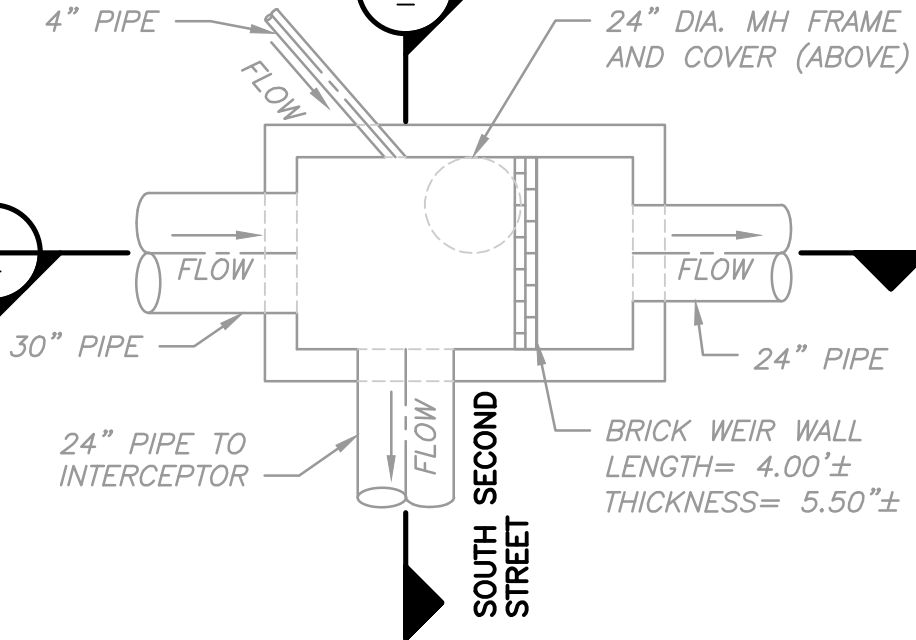

NOTE:
ELEVATIONS SHOWN ARE IN
NEW BEDFORD CITY DATUM.

24" DIA. MH
FRAME AND COVER

