

New Bedford, Ma


Flow Monitoring Site Installation Report



Site I.D.

032C

Site Address / Location:	S 2nd St at Cannon St	Monitor Series	ECHO	Location Type	Temporary
Site Access:	Drive	Pipe Size (H x W)	24x24	Pipe Shape	Circular

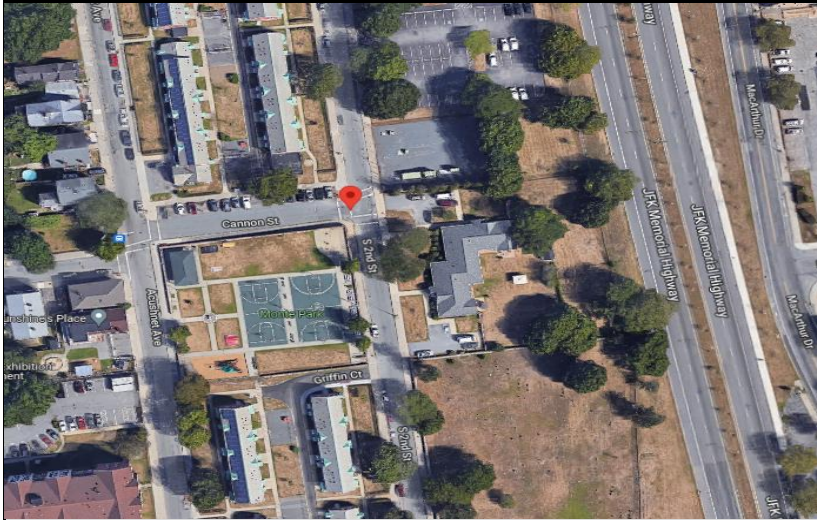

Manhole #	System Characteristics
Access	Commercial
Drive	Traffic
	None



Installation Information	
Installation Date:	Installation Type:
Tuesday, July 26, 2022	Level Only
Monitoring Location (Sensors):	Monitor Location:
Sensors / Devices:	Manhole
ECHO Depth	Pressure Sensor Range (psi)

Installation Confirmation:	
Confirmation Time:	Pipe Size (HxW)
1:30:00 PM	24.00x24.00
Depth of Flow (Wet DOF) (in)	Range (Air DOF) (in)
Downlooker Physical Offset (in)	Measurement Confidence (in)
Peak Velocity (fps)	Velocity Sensor Offset (in)
Silt (in)	Silt Type
0	

Hydraulic Comments:



Manhole / Pipe Information:	
Manhole Depth (Approx. In):	Manhole Configuration
97	CSO Flow Divider
Manhole Material:	Manhole Condition:
Concrete	Good
Manhole Opening Diameter (in)	Manhole Diameter (Approx.):
Manhole Cover	Manhole Frame
Concealed	Normal
Active Drop Connections	Air Quality:
Pipe Material	Good
Brick	Pipe Condition:
	Good

Communication Information:	
Communication Type	Antenna Location
Wireless	Drilled Pavement / Concrete

Additional Site Info. / Comments:

ADS Project Name:	New Bedford, Ma
ADS Project Number:	32673.52