




Notes:
1. Sanitary sewer connections and stubs 6" V.C.P. unless otherwise noted.
2. All connecting pipes to catch basins 15" R.C.P.

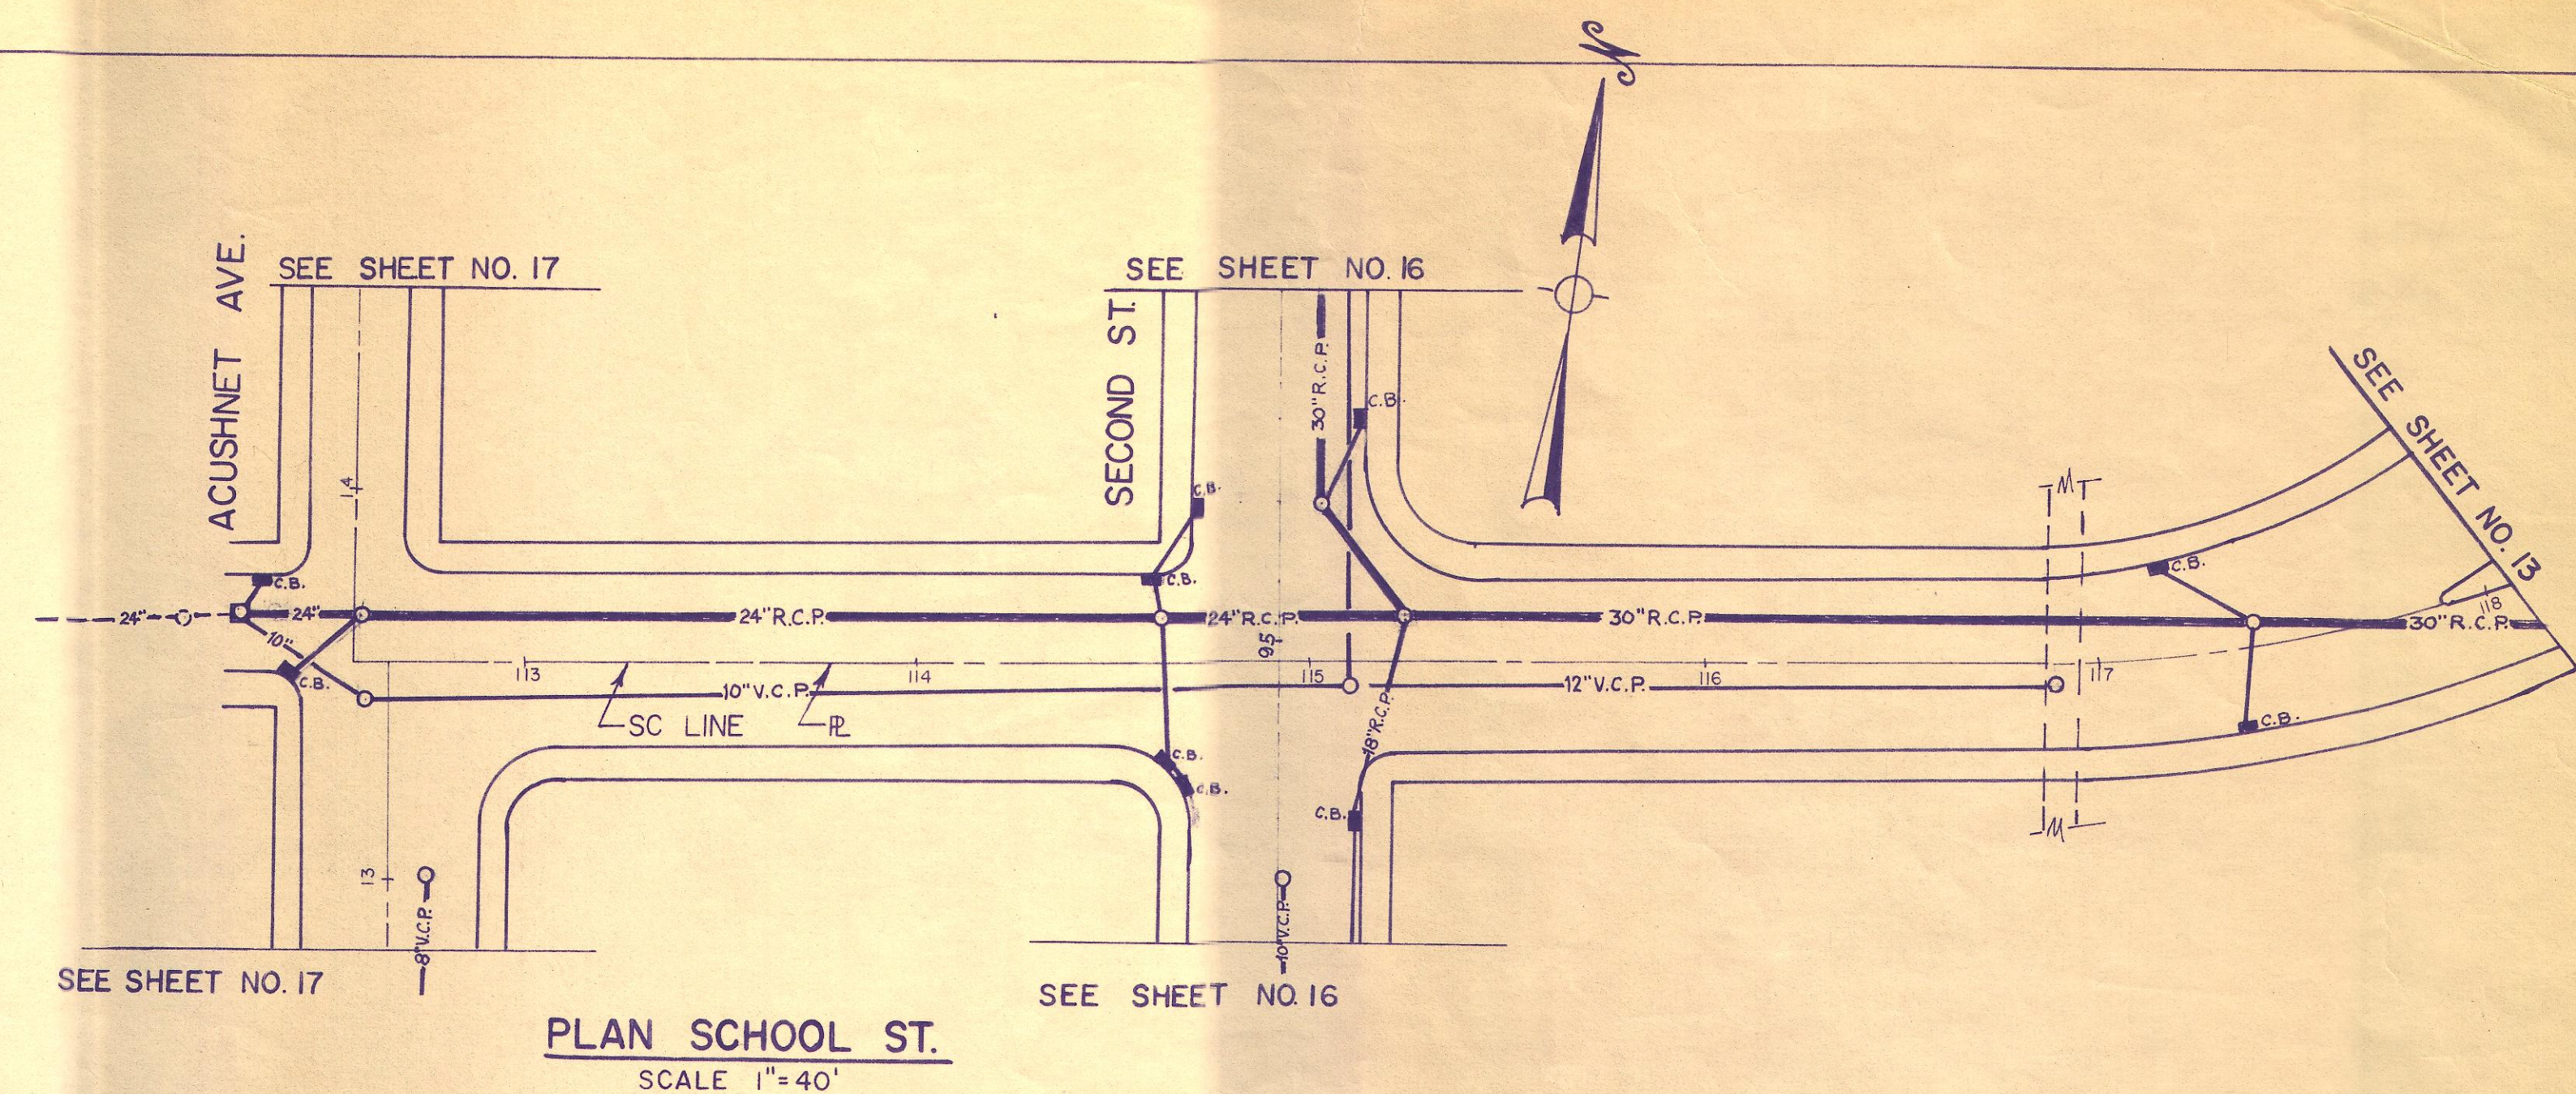