


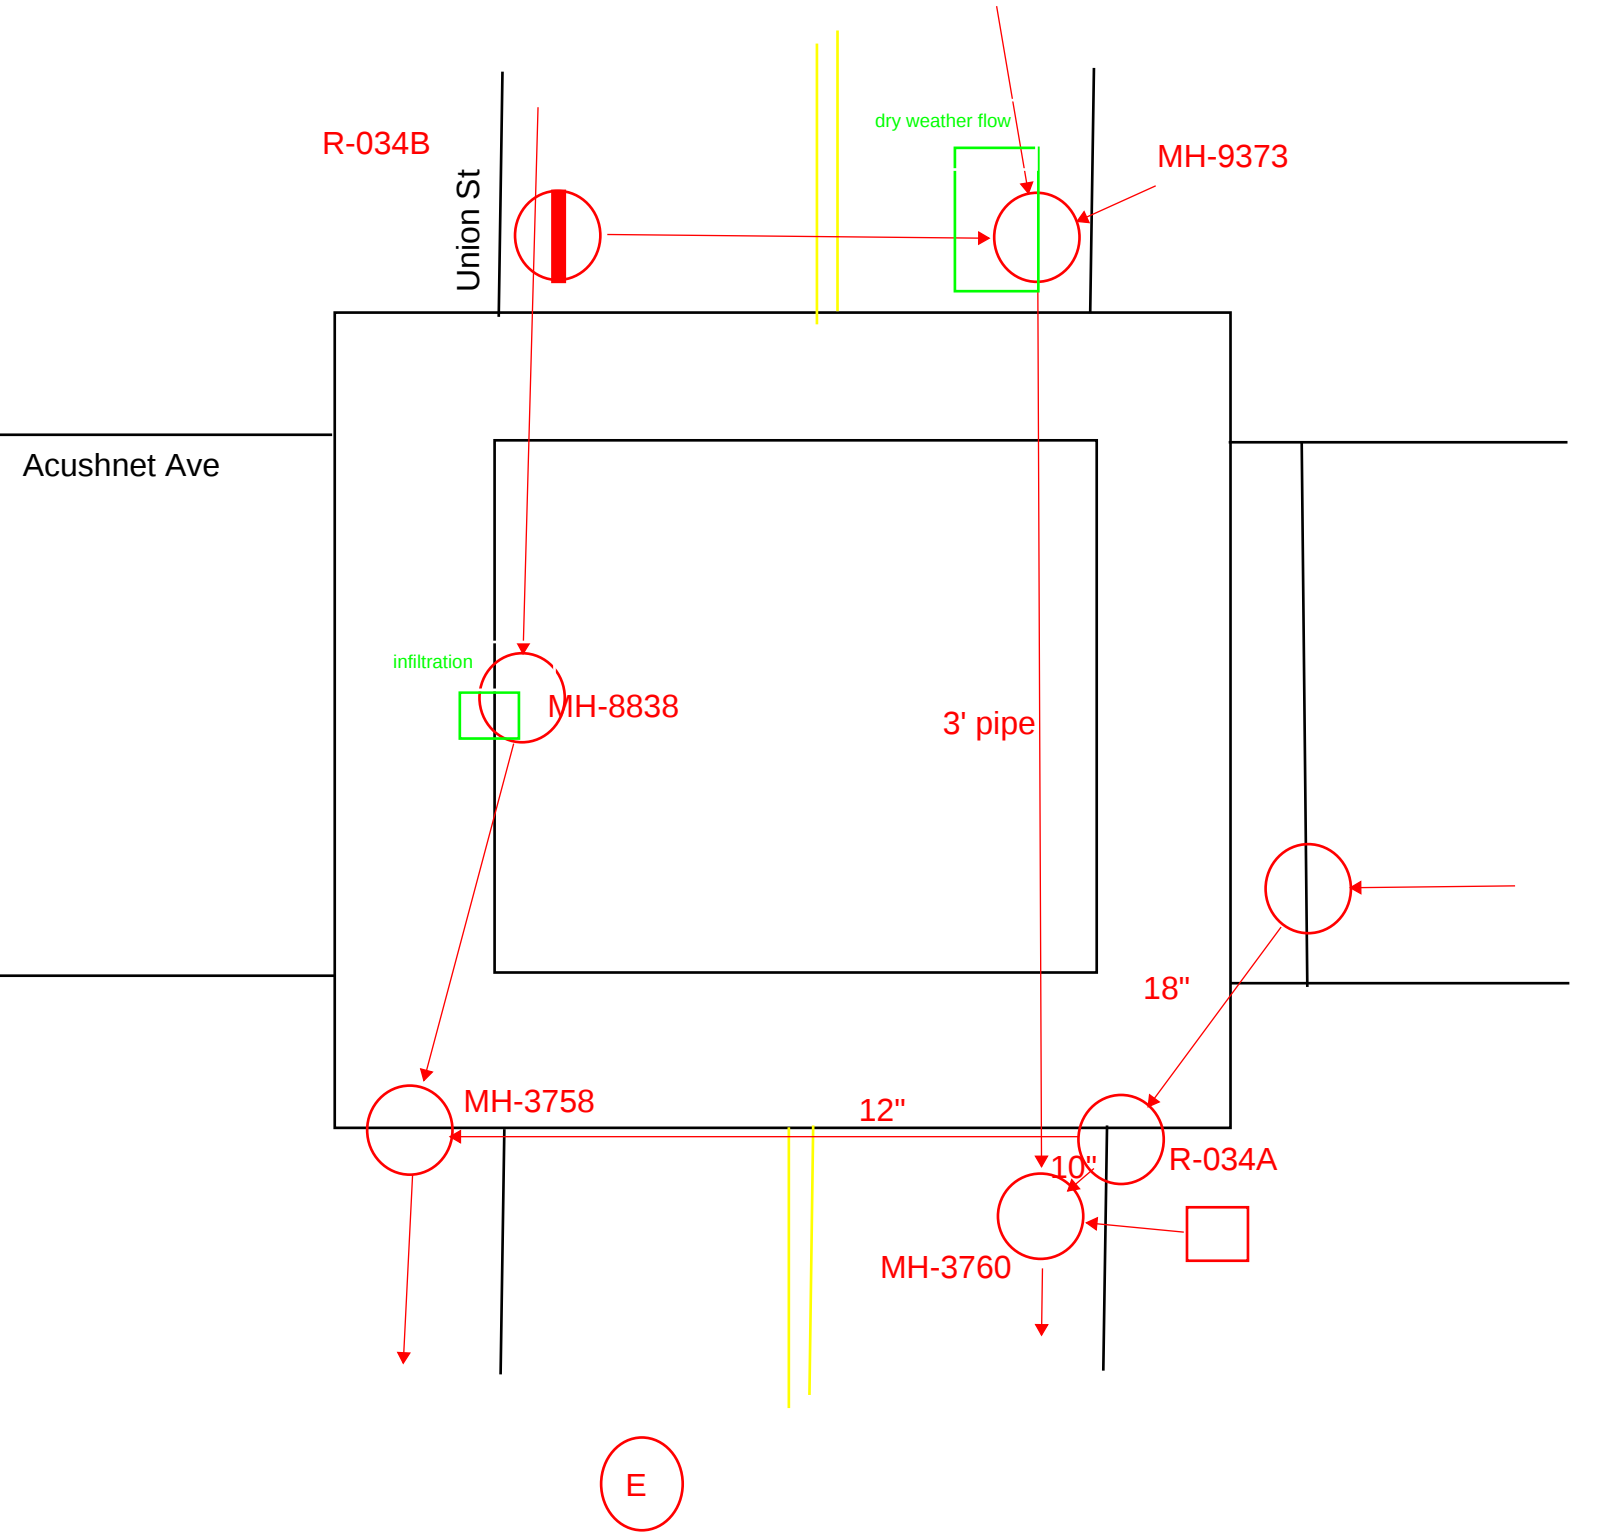

34A Field Measurements:

- High level outlet diam (10-12")
- Rim to inlet= 5'11"
- Rim to dry weather outlet= 7'1"
- Rim to high level outlet= 6'

34A iPhone Lidar Scan:

- High level outlet diam:10"
- Rim to inlet= 6.3
- Rim to dry weather outlet= 7.7
- Rim to high level outlet= 6.5