



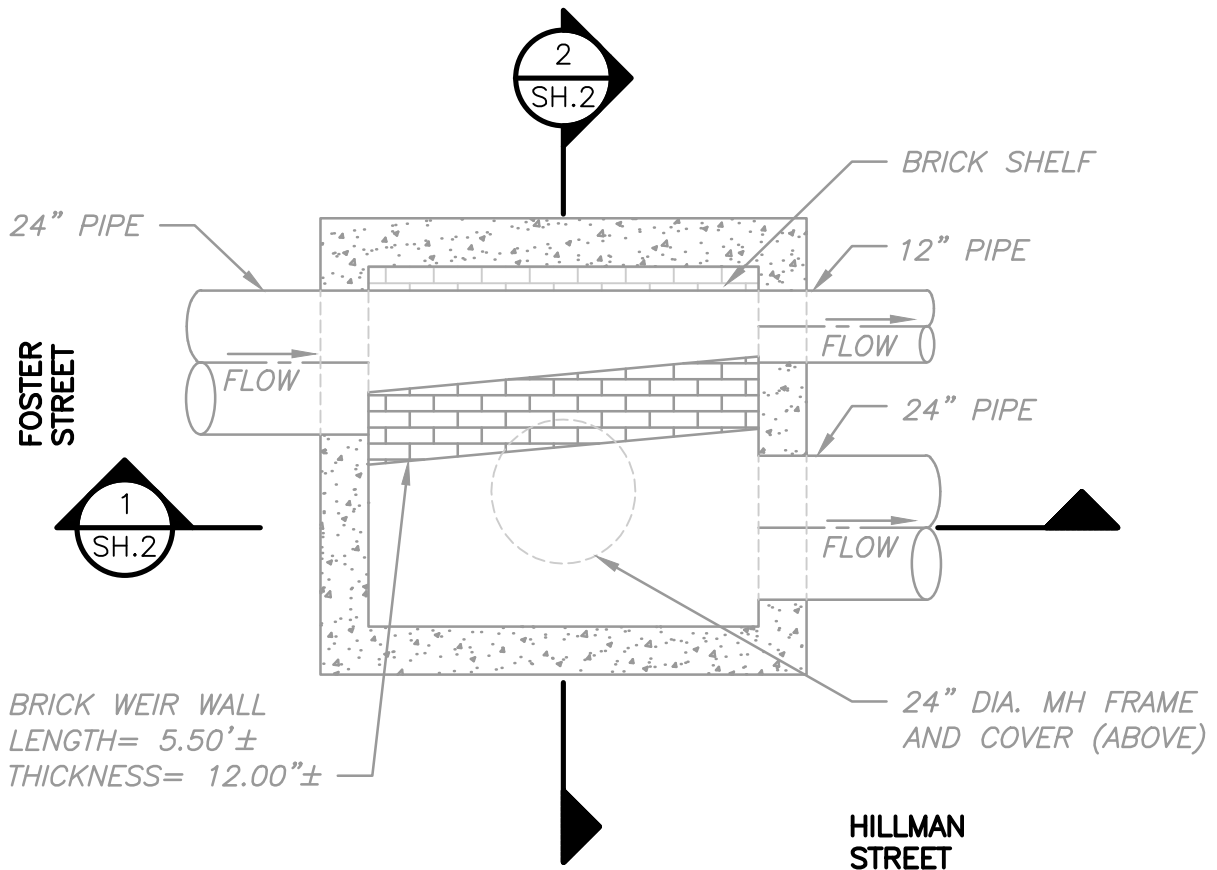

PLAN

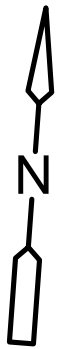