


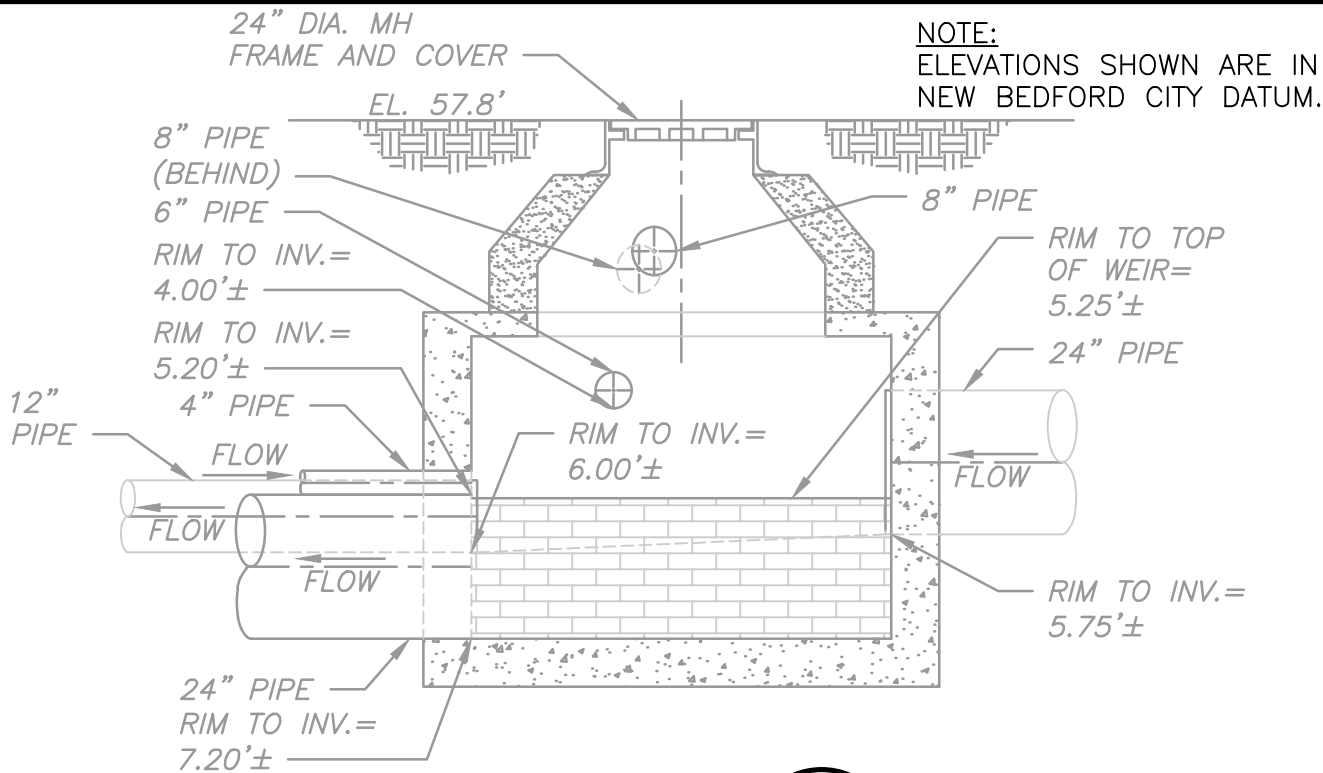


SECTION

3/8" = 1'-0"

1

SH.1

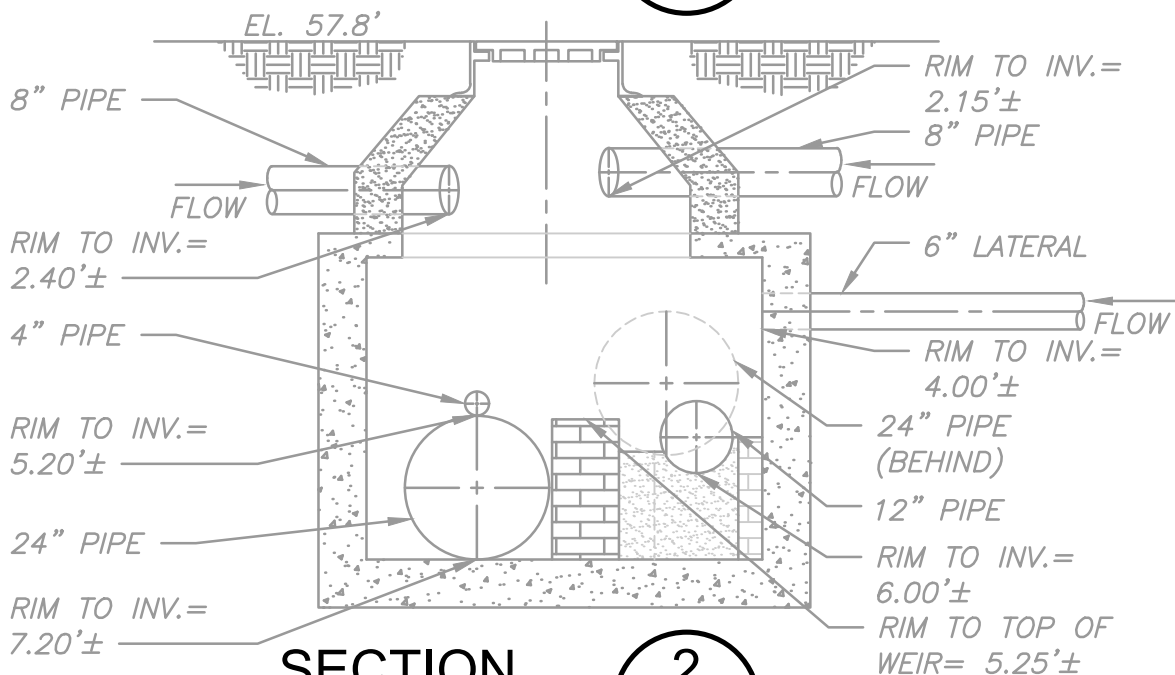

SECTION

3/8" = 1'-0"

2

SH.1

