

# New Bedford Regulator Specification Sheet

**Regulator #:** R-035C

**Location:** Acushnet Ave.

**Date:** 6/25/25

## Structure Measurements

**Structure Type:** Multichamber (3)

**Rim Elevation (ft City Datum):** 9.8

**Regulator Type:** Fixed Weir

**Overflow Height (ft or in):** 0.9'

**Rim to Top of Weir (ft):** 14.6

**Weir Dims (ft or in):** Length: ~5', Height: 0.9' above invert elevation

**Influent pipe ø (in):** 48

**Rim to Influent Invert (ft):** 15.5

**Dry Weather Connection ø (in):** 72

**Rim to Dry Weather Invert (ft):** 15.6

**Overflow pipe ø (in):** 48" opening to 66" or 30"

**Rim to Overflow Invert (ft):** 16.2 (66"), 14.45 (30")

## Sensor Measurements

**Block Present:** No

**Level Sensor Status:** Not Metered


**Sensor Installation Date:** n/a


**Intra-System Status:** No

**Tide Gate Status:** Gate Condition Unknown


**Notes:** Standing water covered all pipes during scan and field visits. Pipe dimensions were taken from Railyard CSO Project record drawings (sheets 4, 13, and 14).

## Location Sketch:

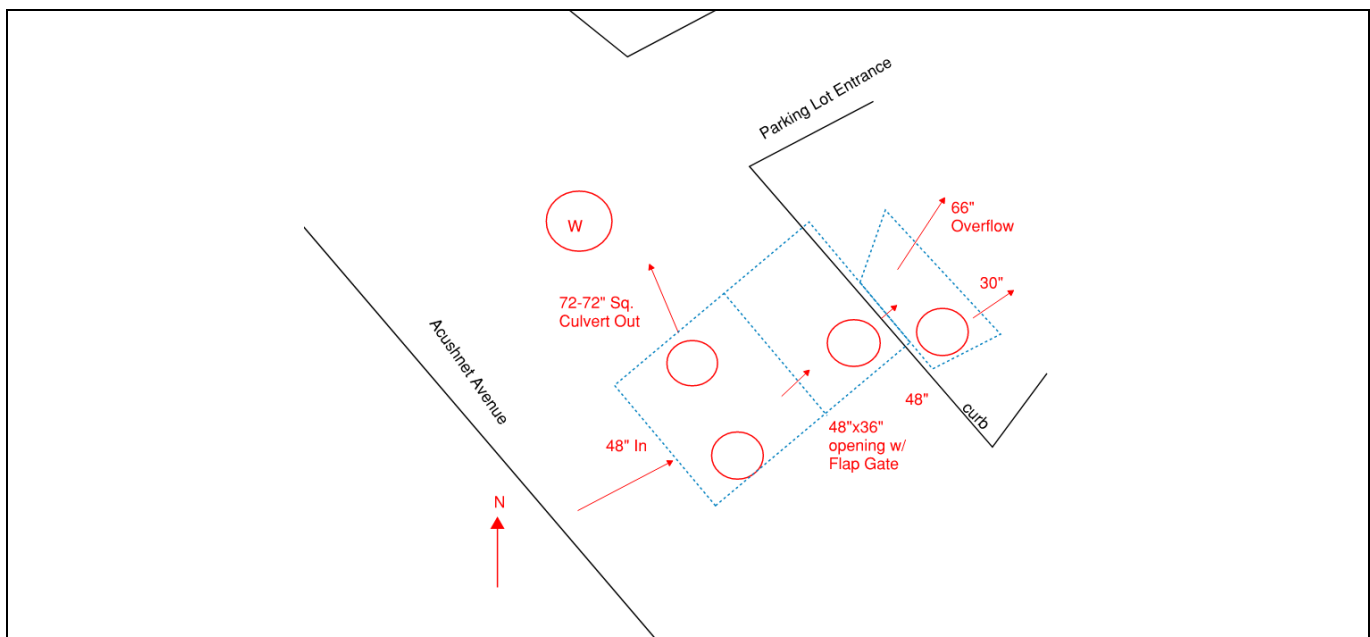

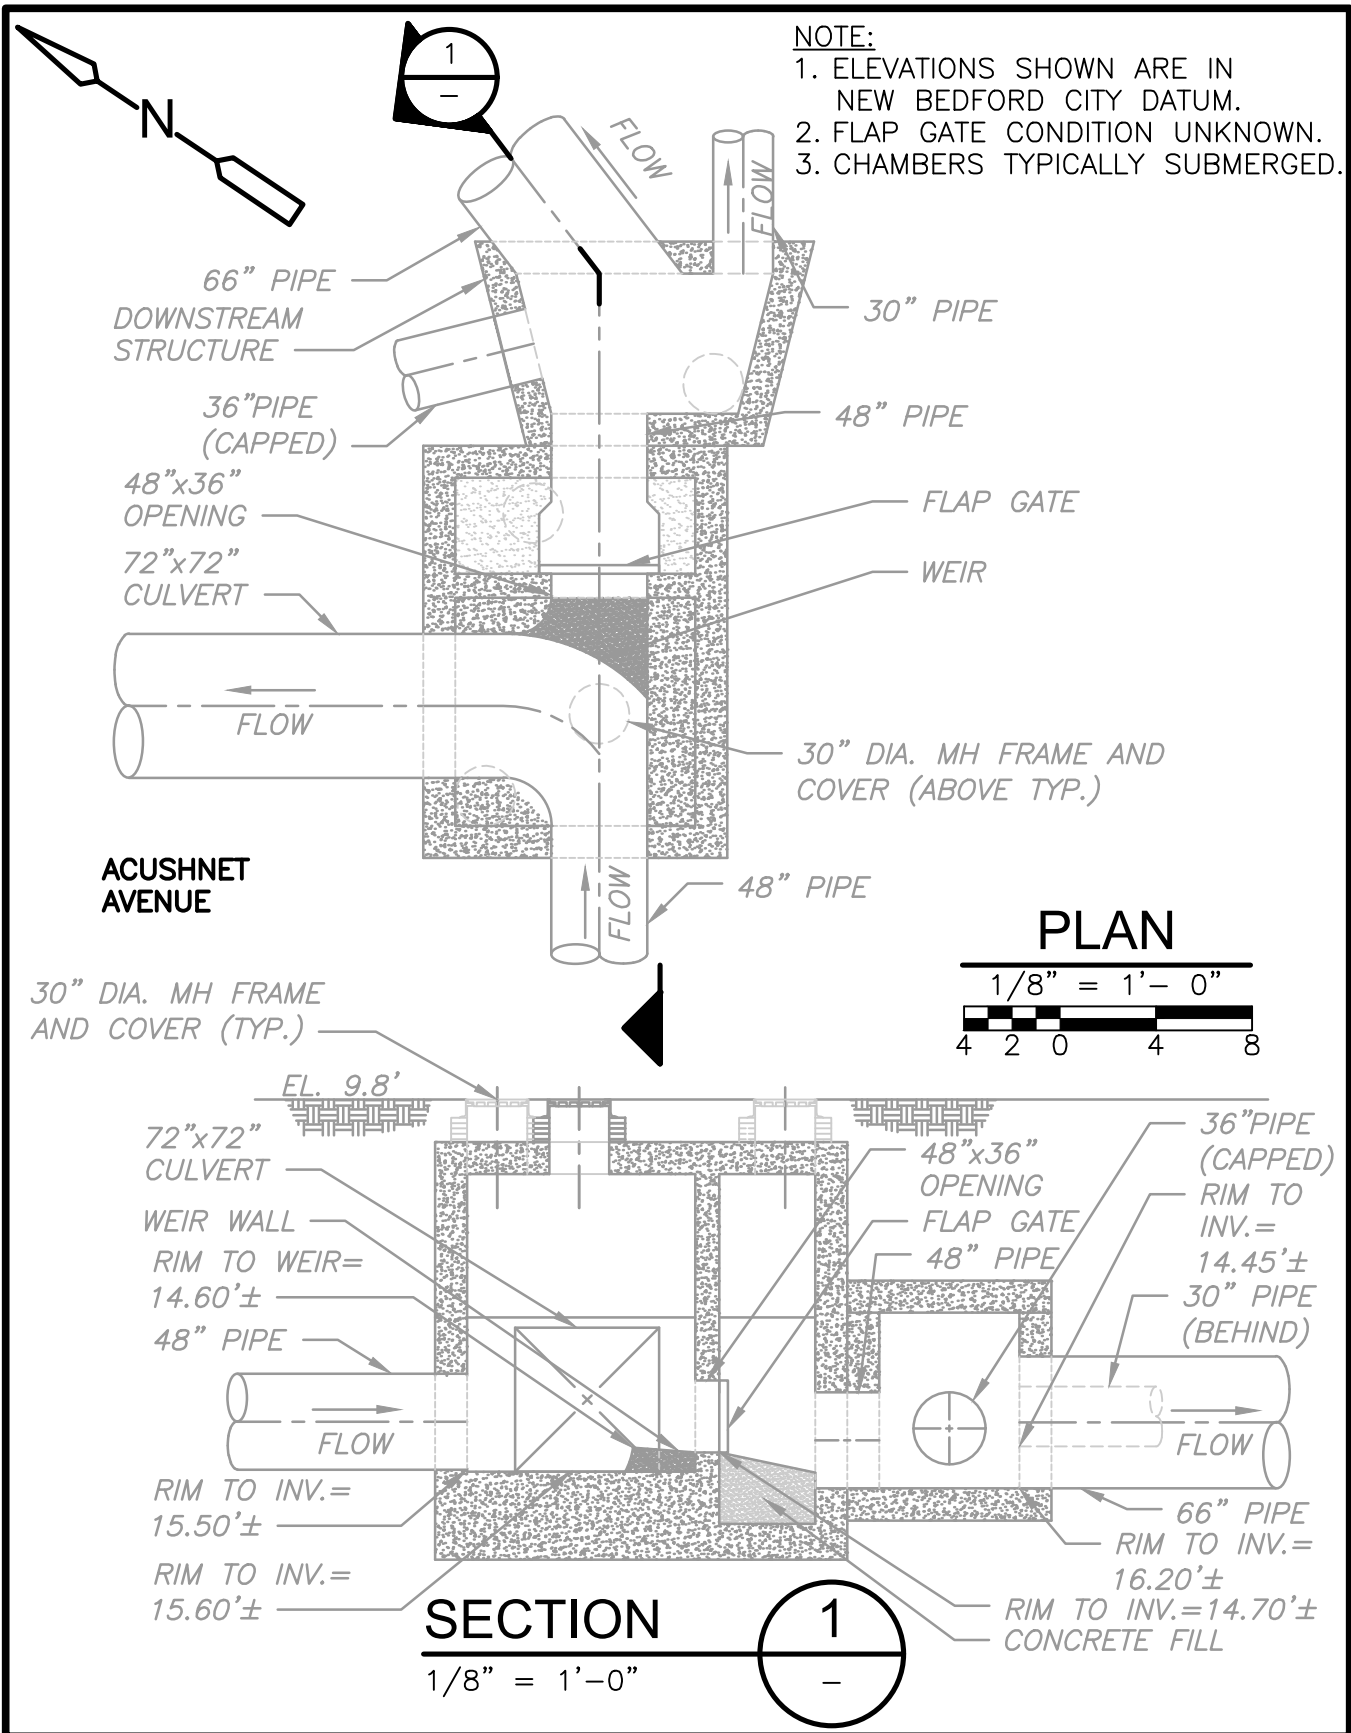



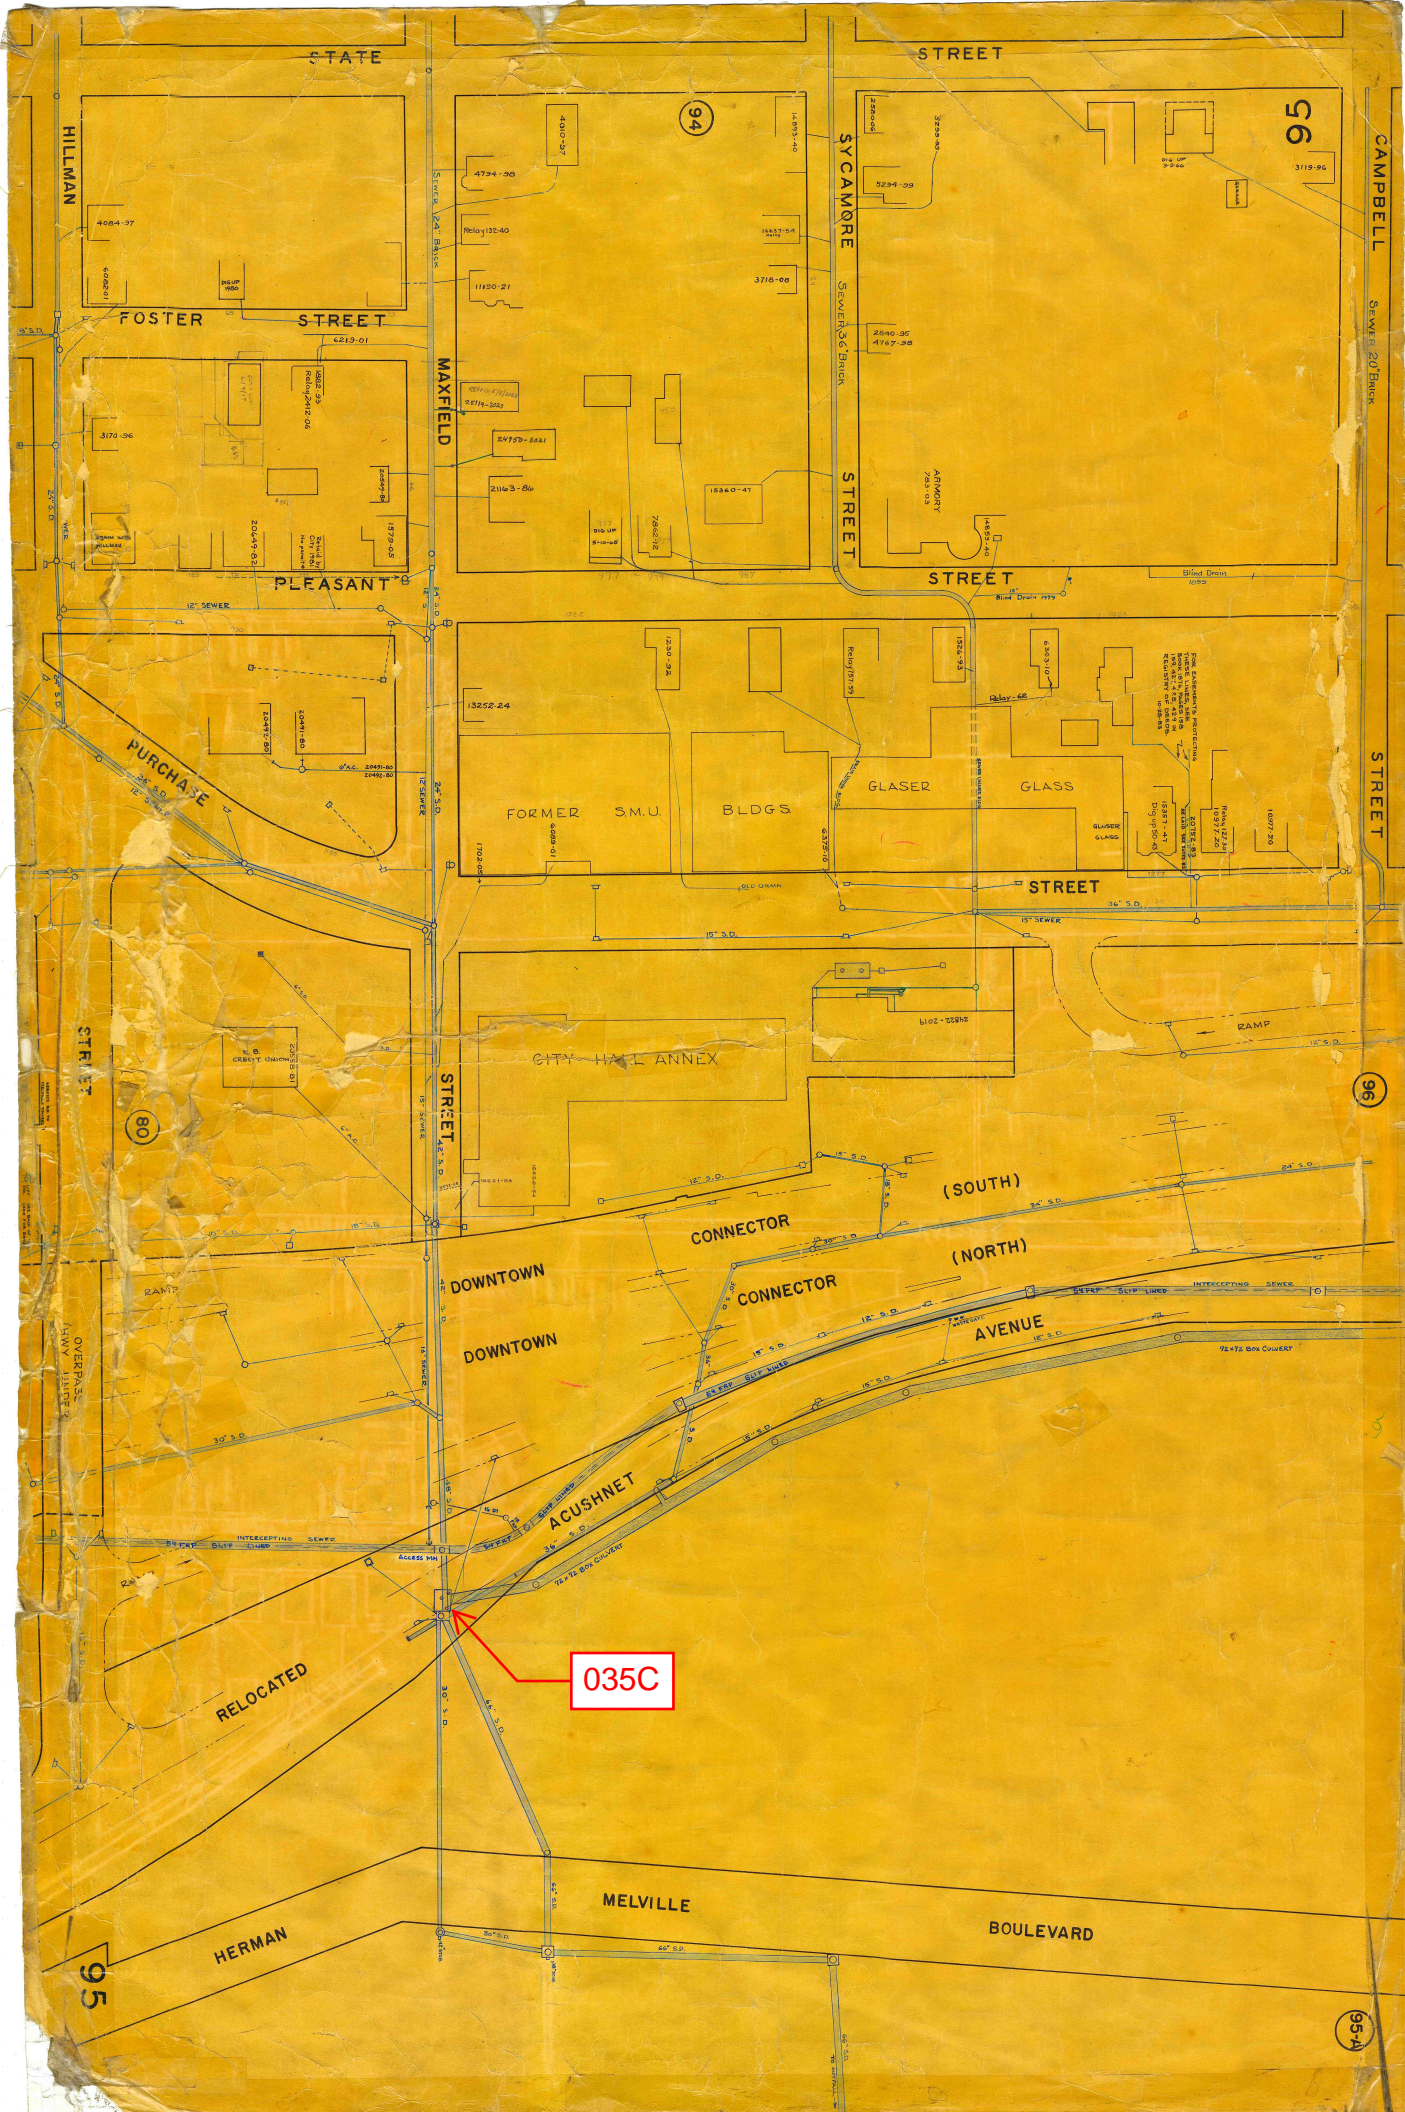

035C



## REGULATOR FIELD PHOTOS

**Figure 1**



**Figure 2**



**Figure 3**



**Figure 4**



### Descriptions:

**Figure 1:** Inside of R-035C. 48-inch inlet pipe visible.

**Figure 2:** Inside of R-035C. 72x72-inch outlet pipe visible.

**Figure 3:** Google Earth snapshot facing north on Acushnet Avenue. Manhole marked in red.

**Figure 4:** Aerial location with arrow pointing to corresponding manhole.