


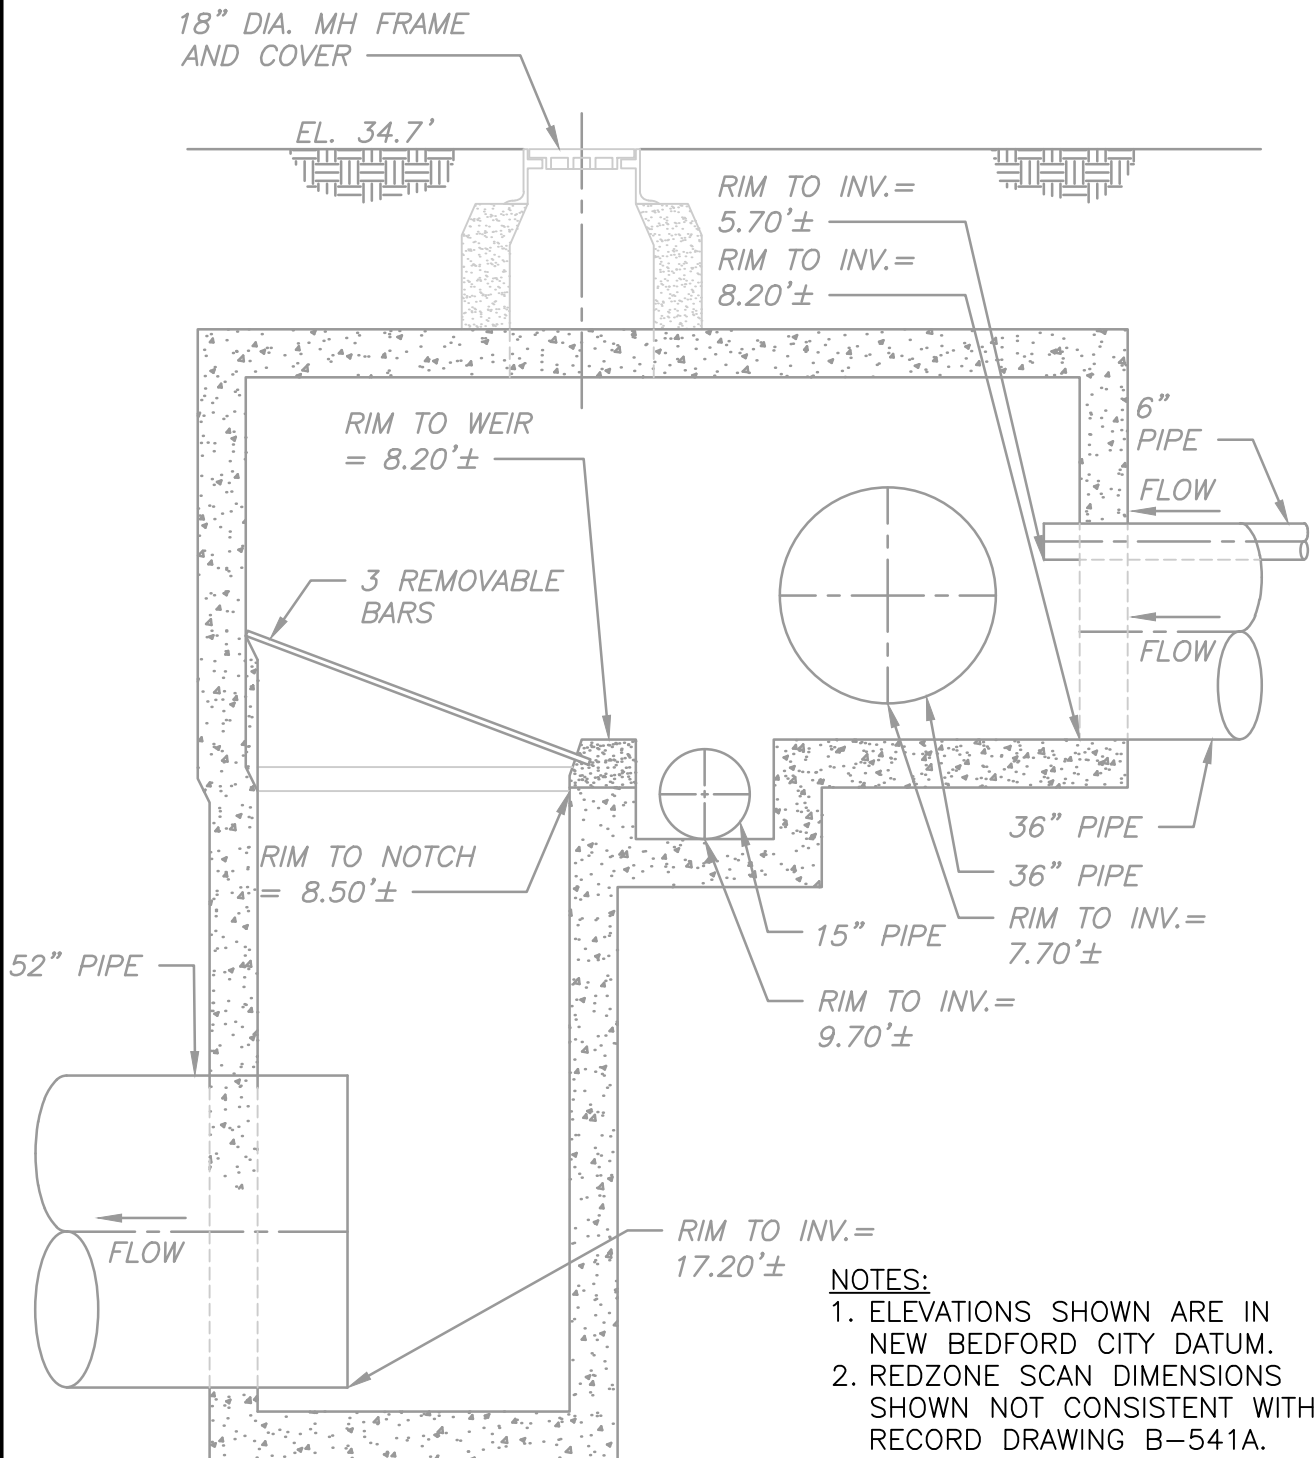

SECTION

3/8" = 1'-0"

1

SH.1