


a division of ADS LLC.

Site Name:	036A	Meter Type:	ECHO	Monitor S/N:	909	MH #:	
Address / Location:	Purchase St at Willis St			GPS N / W :	41.643225	-70.927429	
Access:	Drive	Safety Classification:	1	Type of System:	Combined	Pipe Height:	Inches
						Pipe Width:	Inches
						Communication #	107.80.27.158



Access Photo				Site Map    N ↑			
Investigation Information:				Manhole Information:			
Date/Time of Investigation:	February 28, 2018		4:15PM	Manhole Depth:		114.5 Inches	
Site Hydraulics:				Manhole Material / Condition:		PIP                      Good	
				Active Drop Connections?		No	
Upstream Input: (L/S, P/S):				Pipe Material / Condition:		RCP                      Good	
Upstream Manhole:		Downstream MH:		Manhole Comments:			
Confirmation Information				Overflow Type / Dimensions:		Side Weir	
Depth of Flow (Wet Dof):	0 Inches    +/-    0.25			Overflow Comments:		overflow above 0.0"	
Range (Air Dof):	0 Inches    +/-    0.25			Flow Backup Source / Distance:			
Peak Velocity:	0			Road Cut Length:			
Silt:	0 Inches			Trench Length:			
Surcharge Height:	0 Inches			Mini System Character:		Commercial	

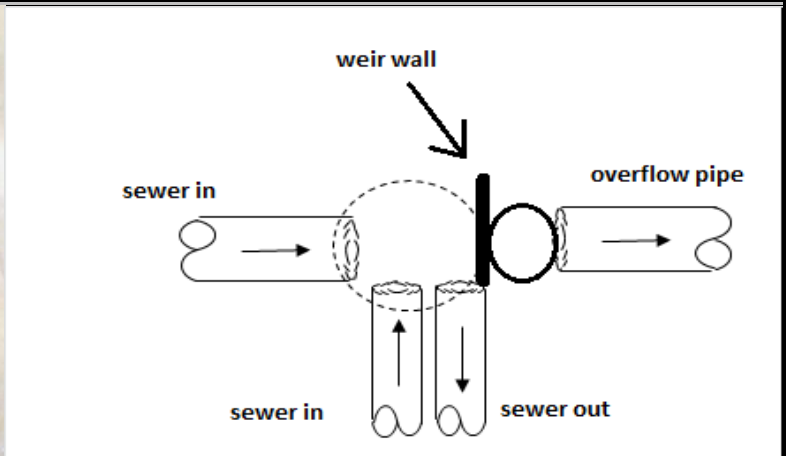

In Pipe Photo				Planar N ↑			
<b>Installation Information</b>				<b>Alarming</b>	<b>Active</b>	<b>Threshold</b>	<b>Units</b>
Installation Type:	Bar LRD						
Sensors / Devices:	Long Range Depth						
Antenna Type / Location:	Mini-Wing	Location:	Road				
Assigned Rain Gauge:							

**Additional Site Information / Comments:**

Detail needed PO 27.38"