

CSO SPEC SHEET

Structure #: REG 036 A

Date: 09/11/2012
Insp. By: AK & AH

Location: At the Intersection of Willis St and Purchase St.

Structure Type: Concrete Weir Wall

Regulator Type: Block Regulator

Structure DIM's: _____

Weir Dim's: _____

Size of Sewer Pipe: 24"

Rim to Weir Wall: 9.6'

Size of Storm Drain Pipe: 48"

Rim to Storm Drain Invert: _____

Sewer Direction: West to South

Rim to Top of Sewer (Normal Flow): 10.3'

Free Board: 0.7'

Over All Rating: (Circle One)

Poor


Fair

Good

Excellent

Comments: No Repairs Needed.

Field Sketch:

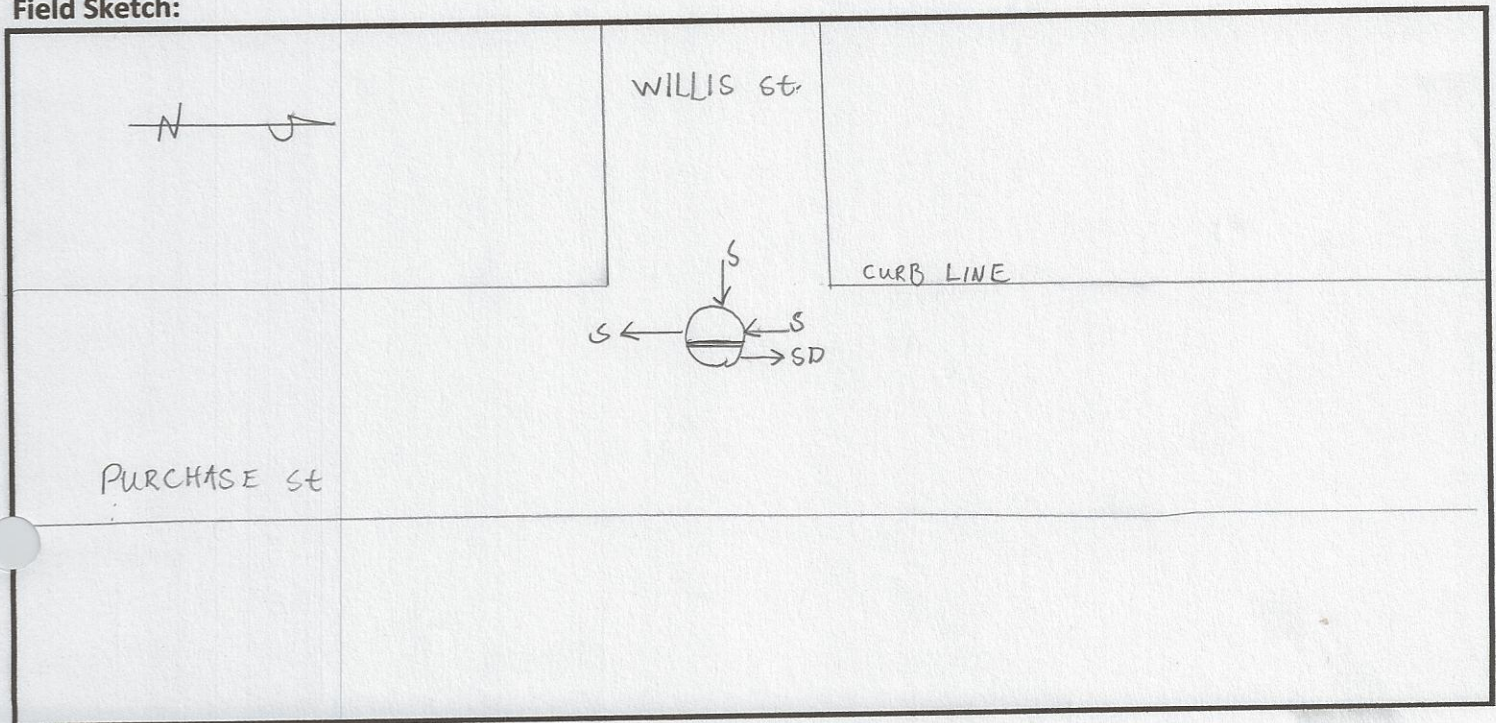

CSO FIELD PHOTOS

Structure#: REG 036 A

Location: At the Intersection of Willis St and Purchase St.

Figure 1.



Figure 2.



Figure 3.




Descriptions

Figure 1: View of Regulator 036 A. Facing North. A- REG 036 A.

Figure 2: Inside view of manhole. A- Sewer; B- Weir Wall; C- Storm Drain.

Figure 3: Google Earth Image of location of Regulator 036 A. A- Reg 036 A.

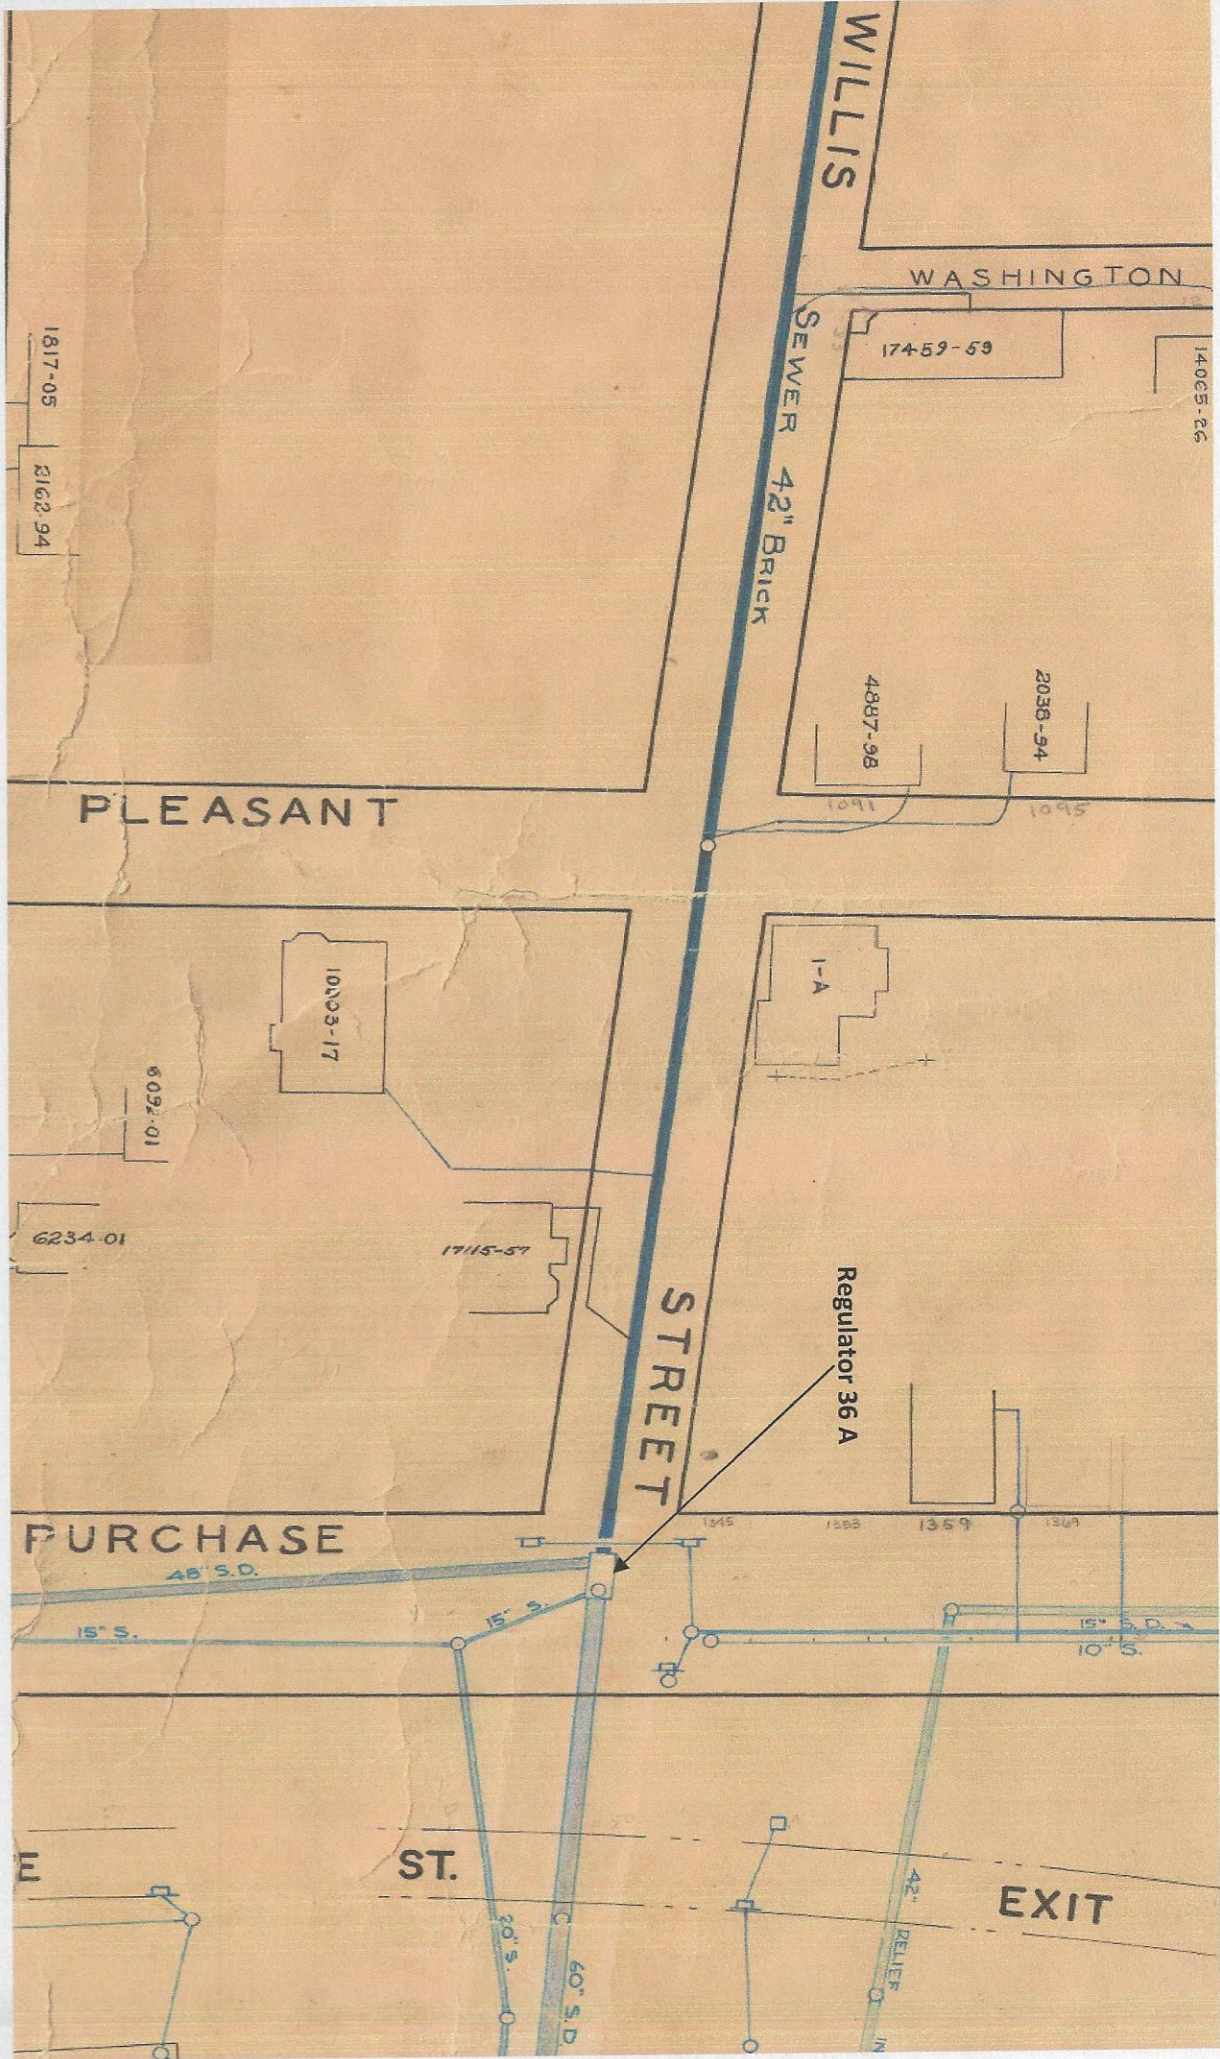

CSO/Regulator Repair Log

Structure #: Reg 036A

[illegible]