
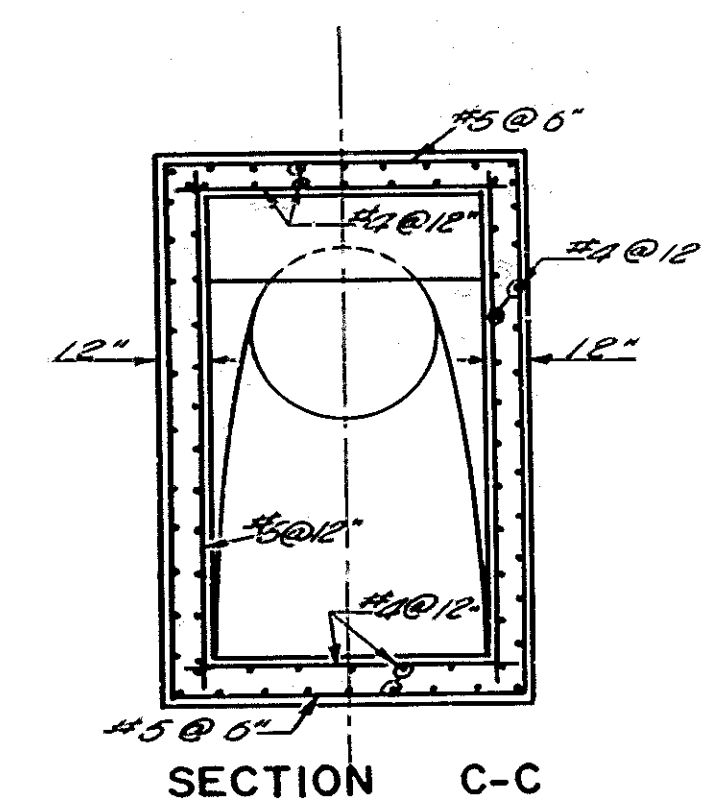



NEW BEDFORD RTE. 18 (CITY CONNECTOR)				
PUB. RD. DIV. NO.	STATE	FED. AID PROJ. NO.	FISCAL YEAR	TOTAL SHEET NO.
1	MASS.	U-143-(10)	36	287

**DRAINAGE
WILLIS ST. - OUTFALL**

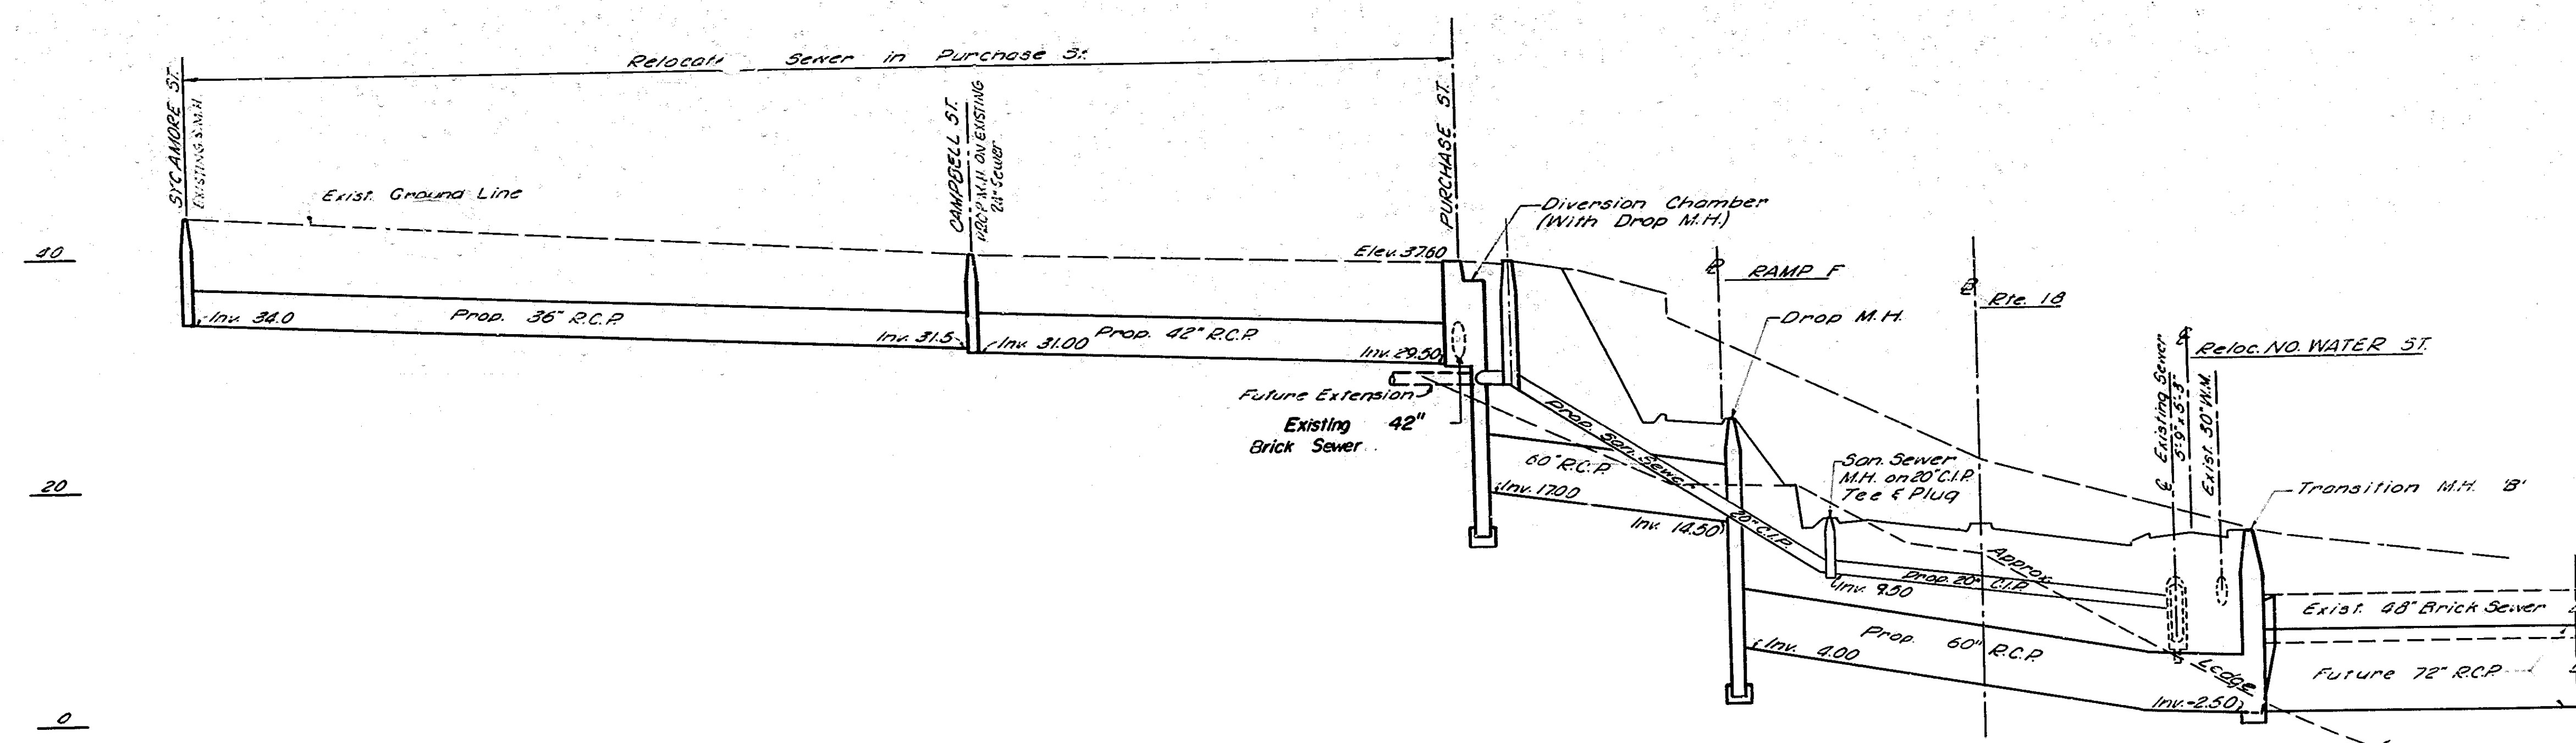


PROFILE : OUTFALL DRAIN AT WILLIS ST.

SCALE : 1" = 40' HORZ.
1" = 8' VERT.

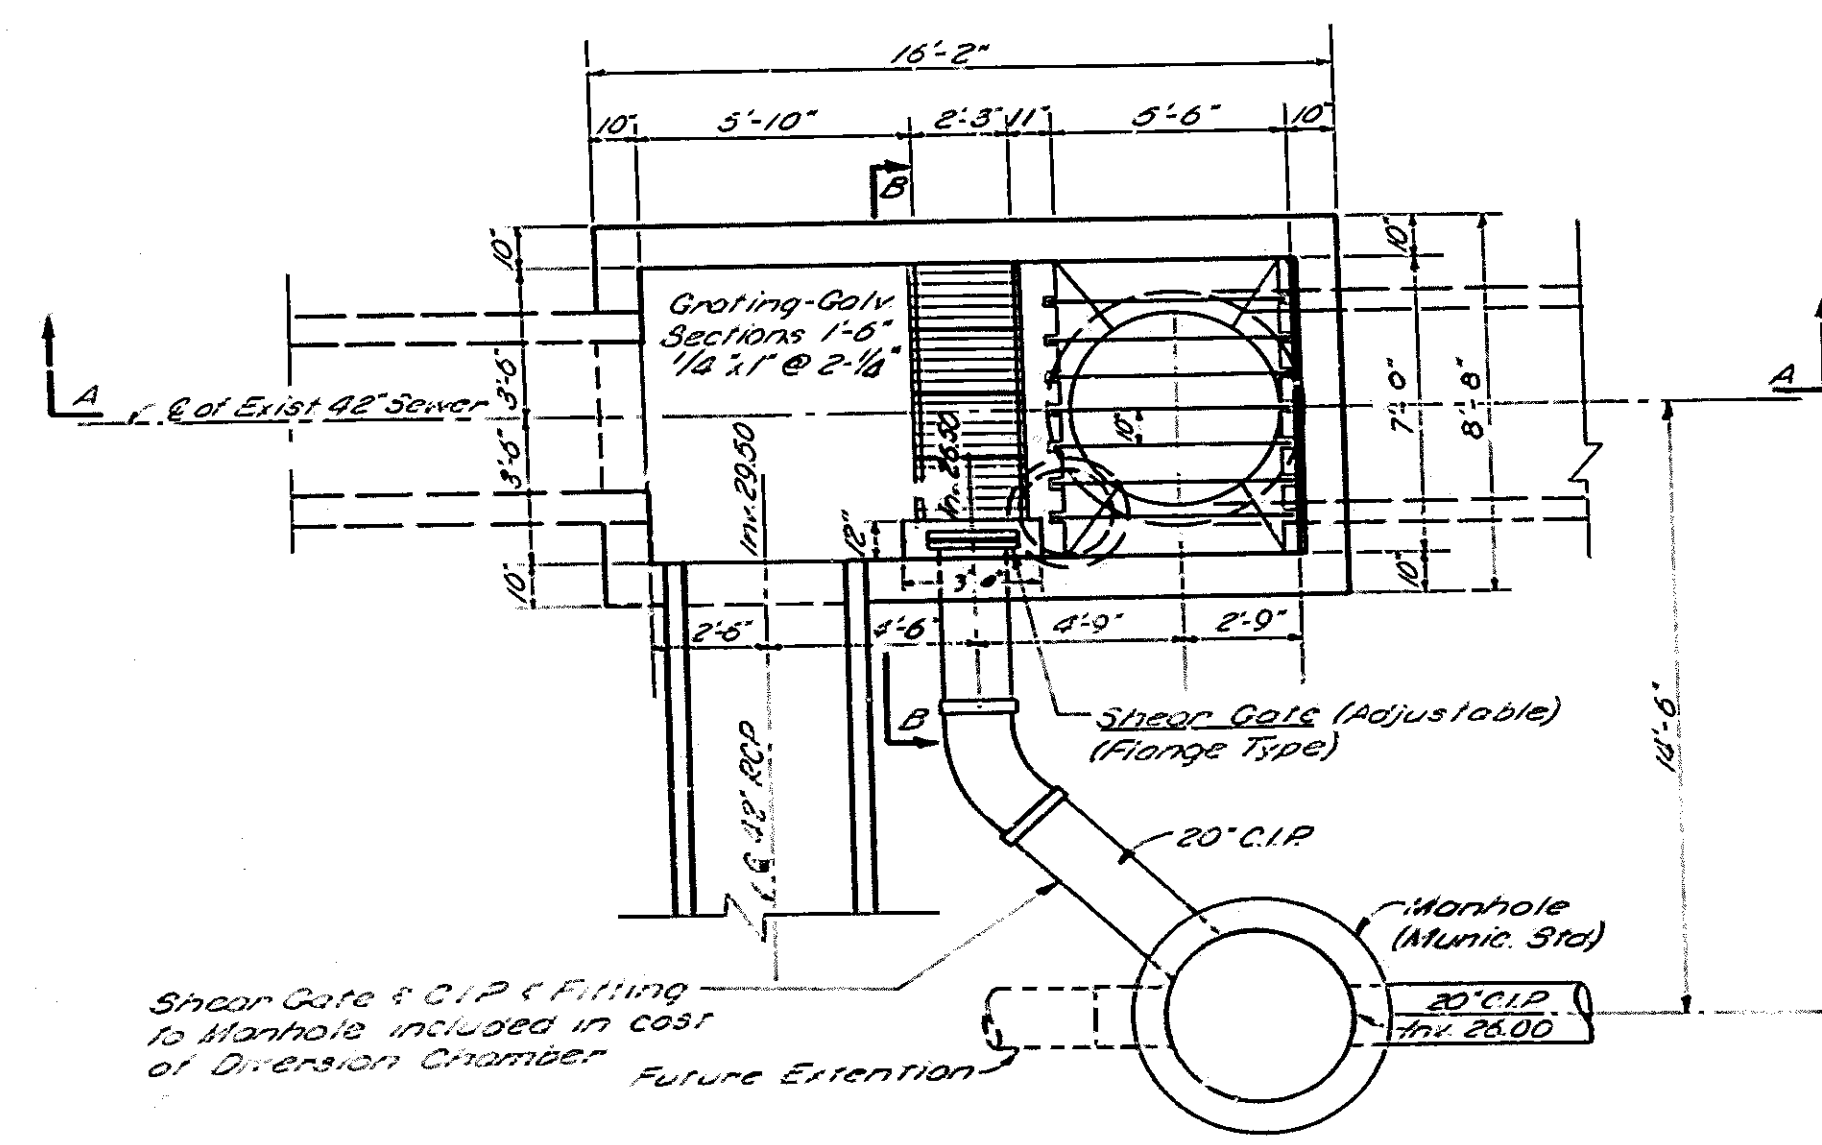


PLAN OF DIVERSION CHAMBER

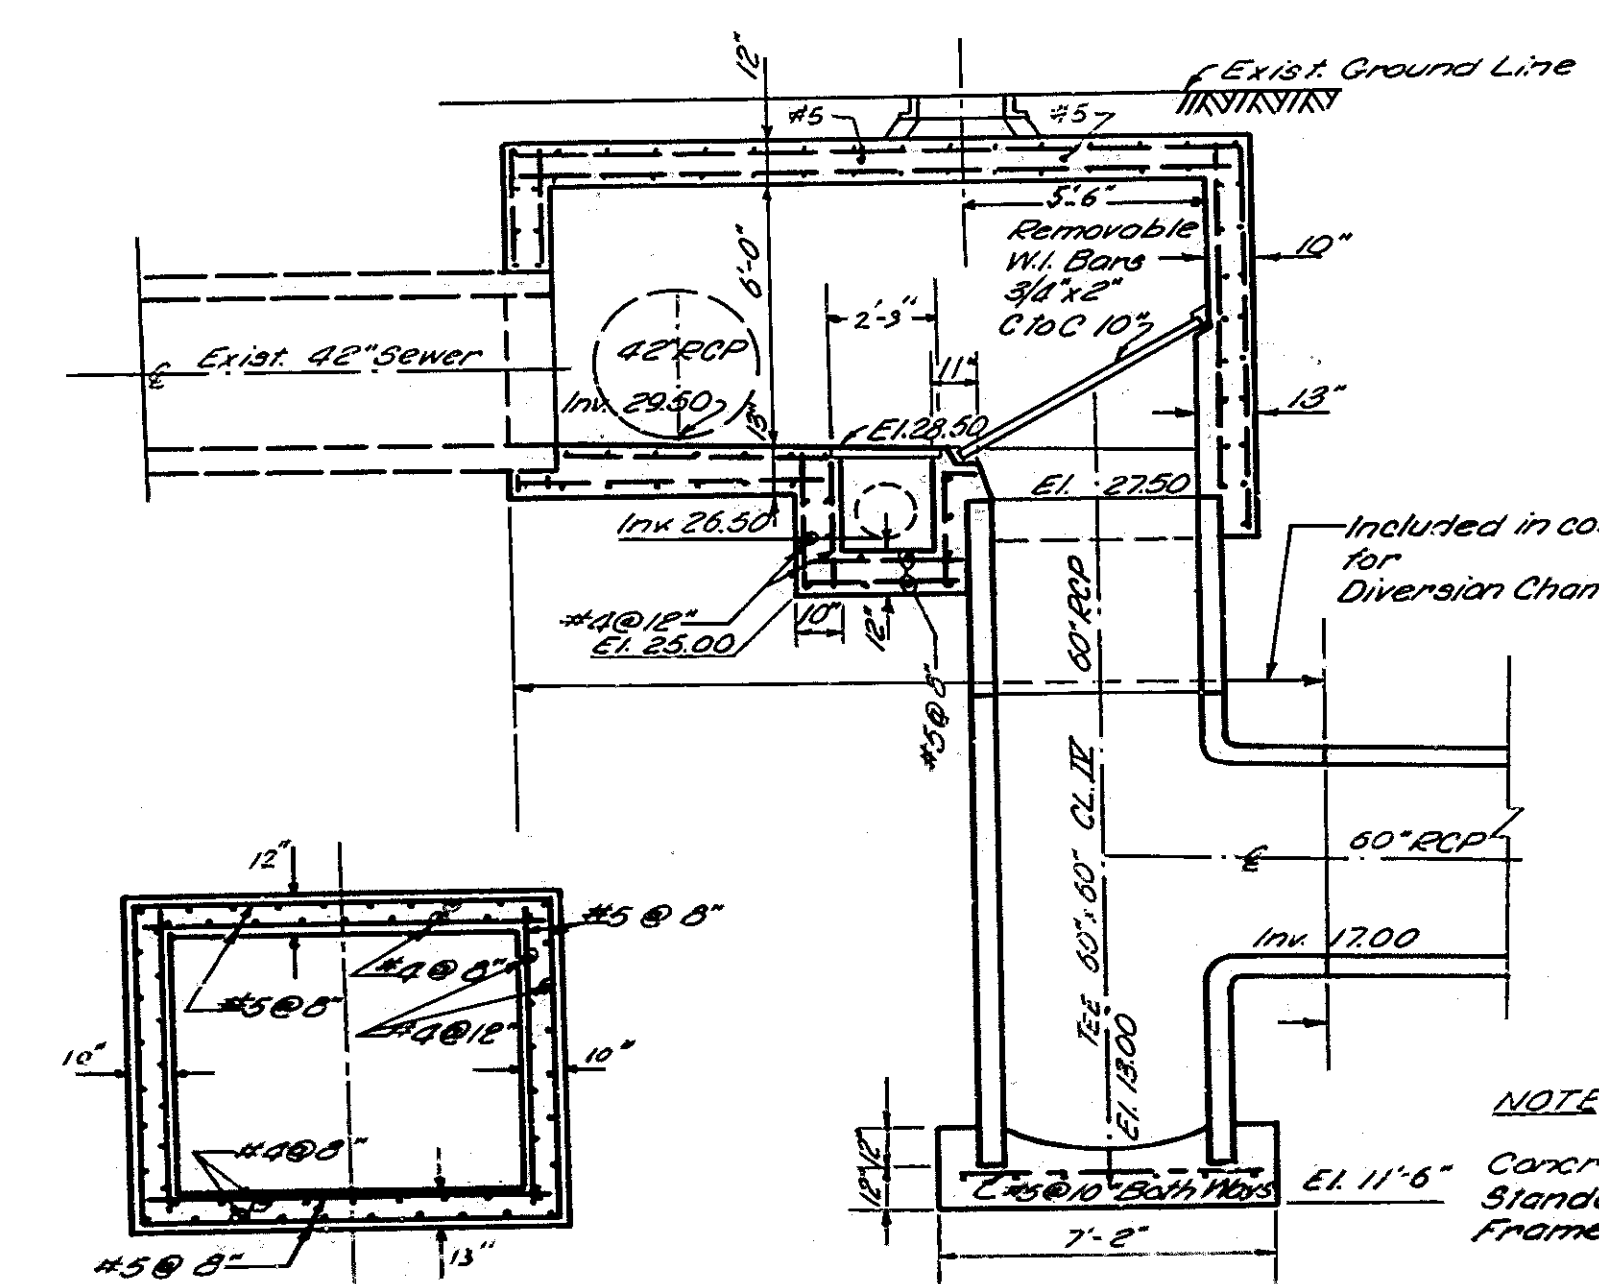


SECTION B-B

SECTION A-A

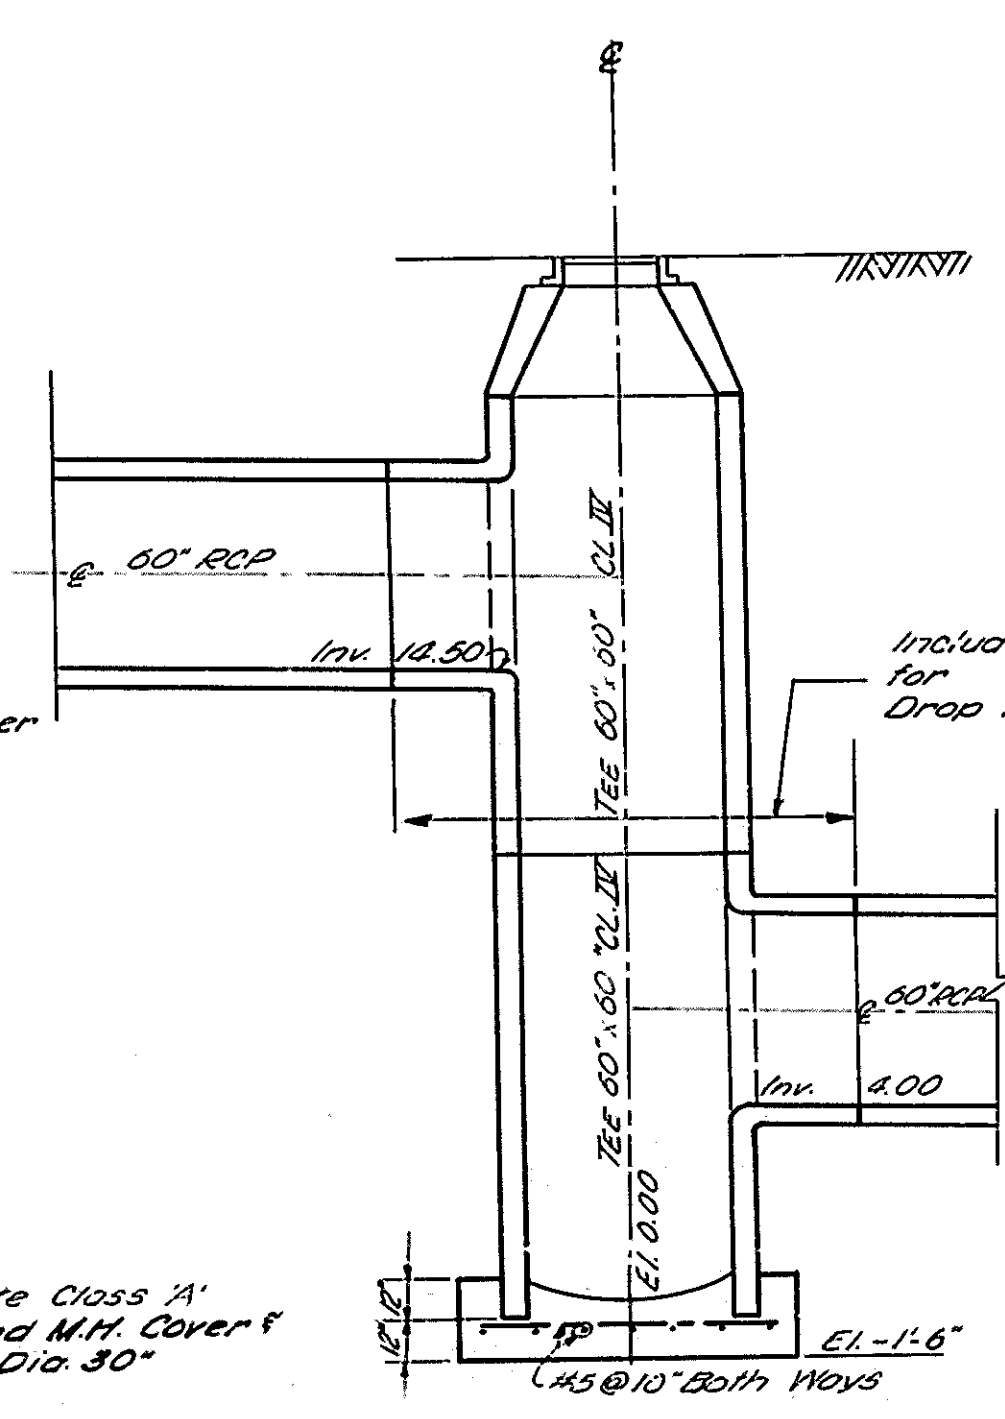

DROP MANHOLE SECTION

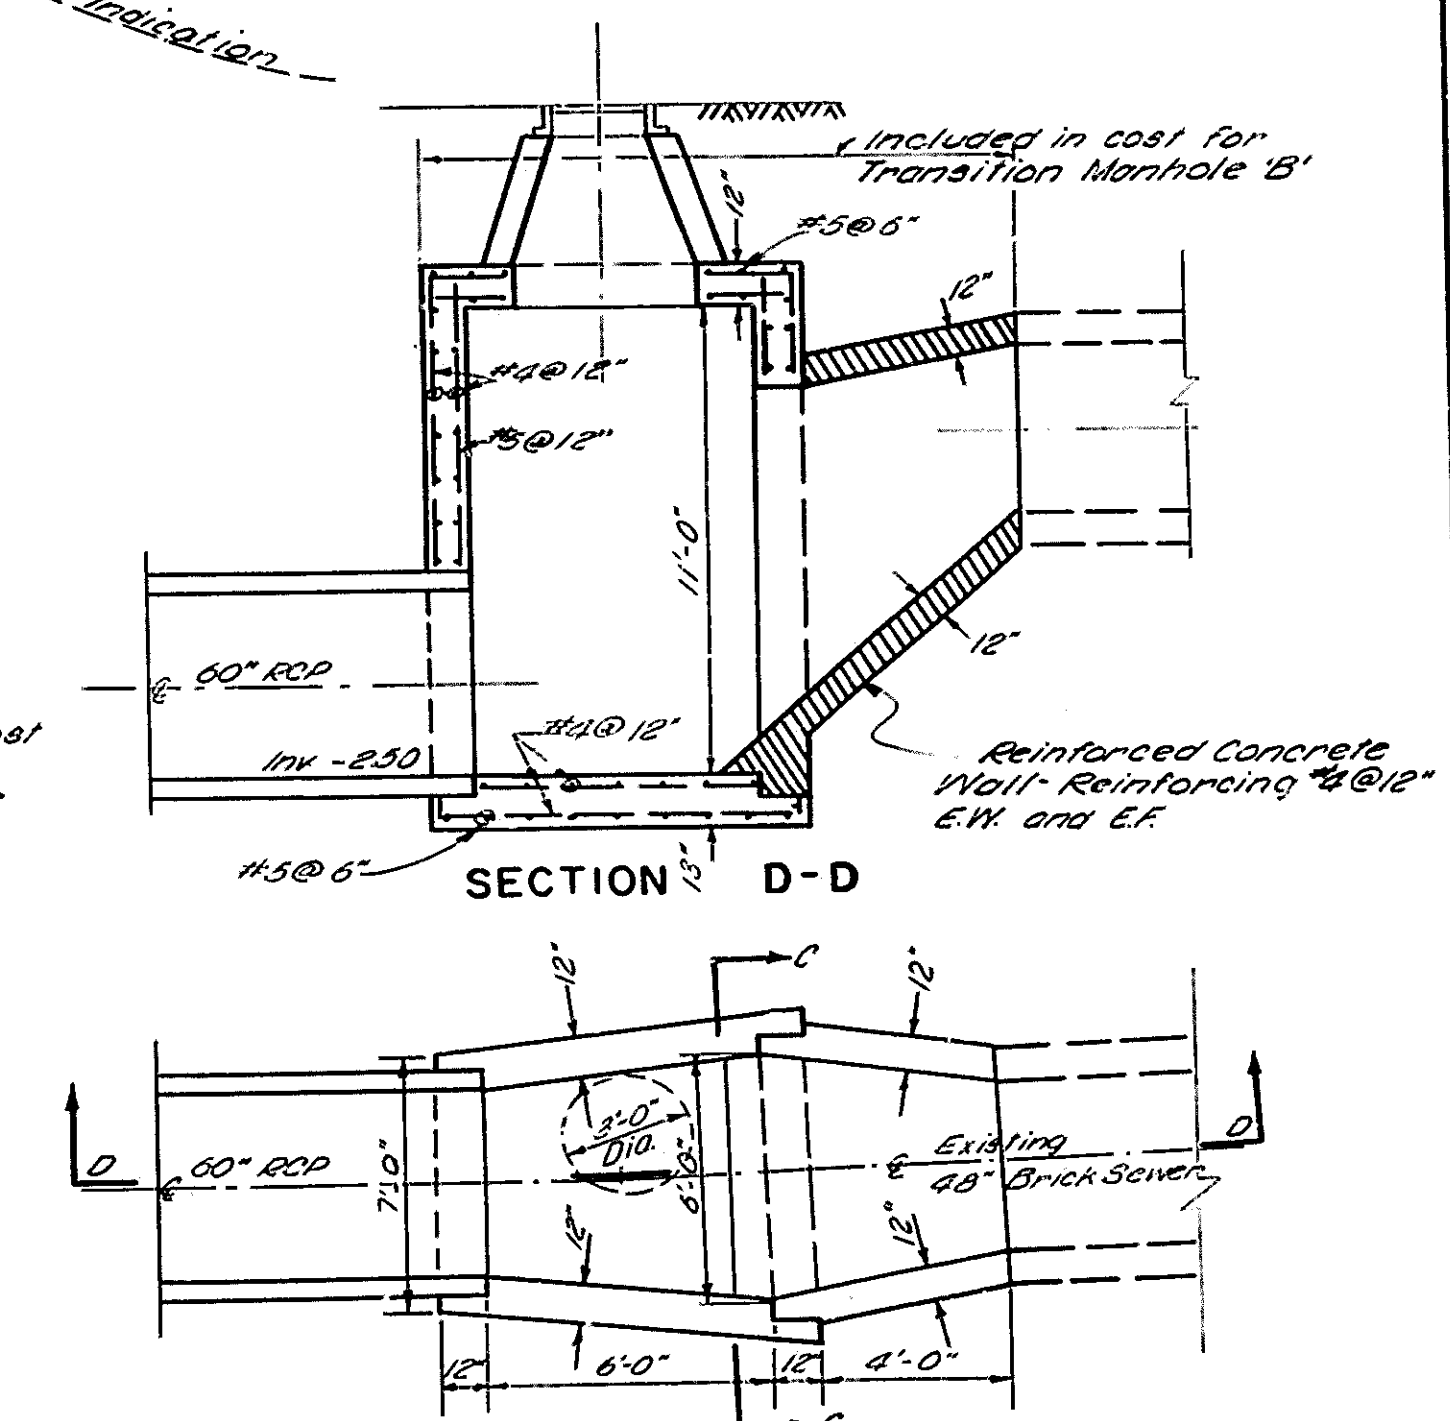

SECTION D-D

PLAN OF TRANSITION MANHOLE 'B'

SCALE: 1/4" = 1'-0"

FILE NO. 7291