




## METER SITE INFORMATION FIELD LOG

<b>PROJECT:</b> New Bedford, MA	<b>DATE:</b> May 8, 2019	<b>JOB#:</b> 19000
<b>LOCATION:</b> Route 18, Purchase Street Exit (under guardrail)	<b>MH#:</b> 4156	<b>METER SITE:</b> 036A
<b>GPS/COMMENTS:</b> 41.643335, -70.927038		



	Size (")	Material	Flow Depth (")	Debris (")	Shape	MH Depth
Incoming	60	Concrete	0	0	Circular	09' 02"
Incoming						
Incoming						
Outgoing	60	Concrete	0	0	Circular	19' 03"

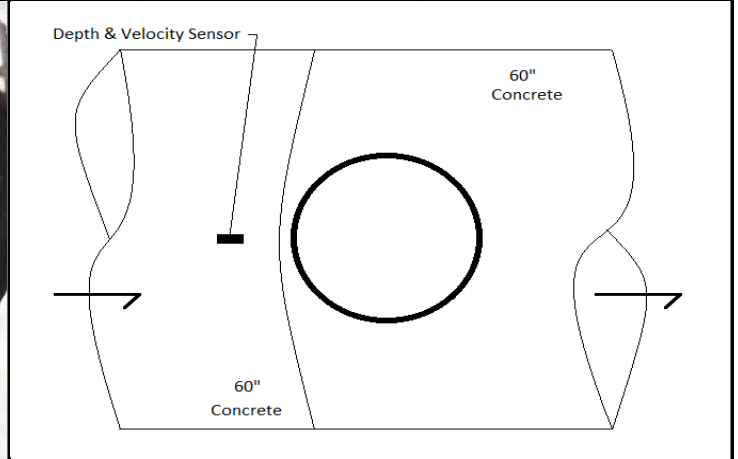

### SURCHARGE INFORMATION

<b>SURCHARGE NONE EVIDENT:</b> X
<b>SURCHARGED MARKS TO:</b>
<b>SURCHARGE CURRENTLY TO:</b>

### WEIR INFORMATION

<b>LENGTH:</b>	<b>HEIGHT ABOVE WEIR:</b>
<b>BREADTH:</b>	<b>OVERFLOW OCCURS AT:</b>
<b>LEVEL:</b>	

