

CSO SPEC SHEET

Structure #: REG 036 B

Date: 09/ 11 / 2012

Insp. By: AK & AH

Location: At the Intersection of Pearl St and Purchase St.

Structure Type: Brick Weir Wall

Regulator Type: Block Regulator

Structure DIM's: _____

Weir Dim's: _____

Size of Sewer Pipe: 10"

Rim to Weir Wall: 5.8'

Size of Storm Drain Pipe: 15"

Rim to Storm Drain Invert: _____

Sewer Direction: West to East

Rim to Top of Sewer (Normal Flow): 7.4'

Free Board: 1.6'

Over All Rating: (Circle One)

Poor


Fair

Good

Excellent

Comments: Needs cleaning.

Field Sketch:

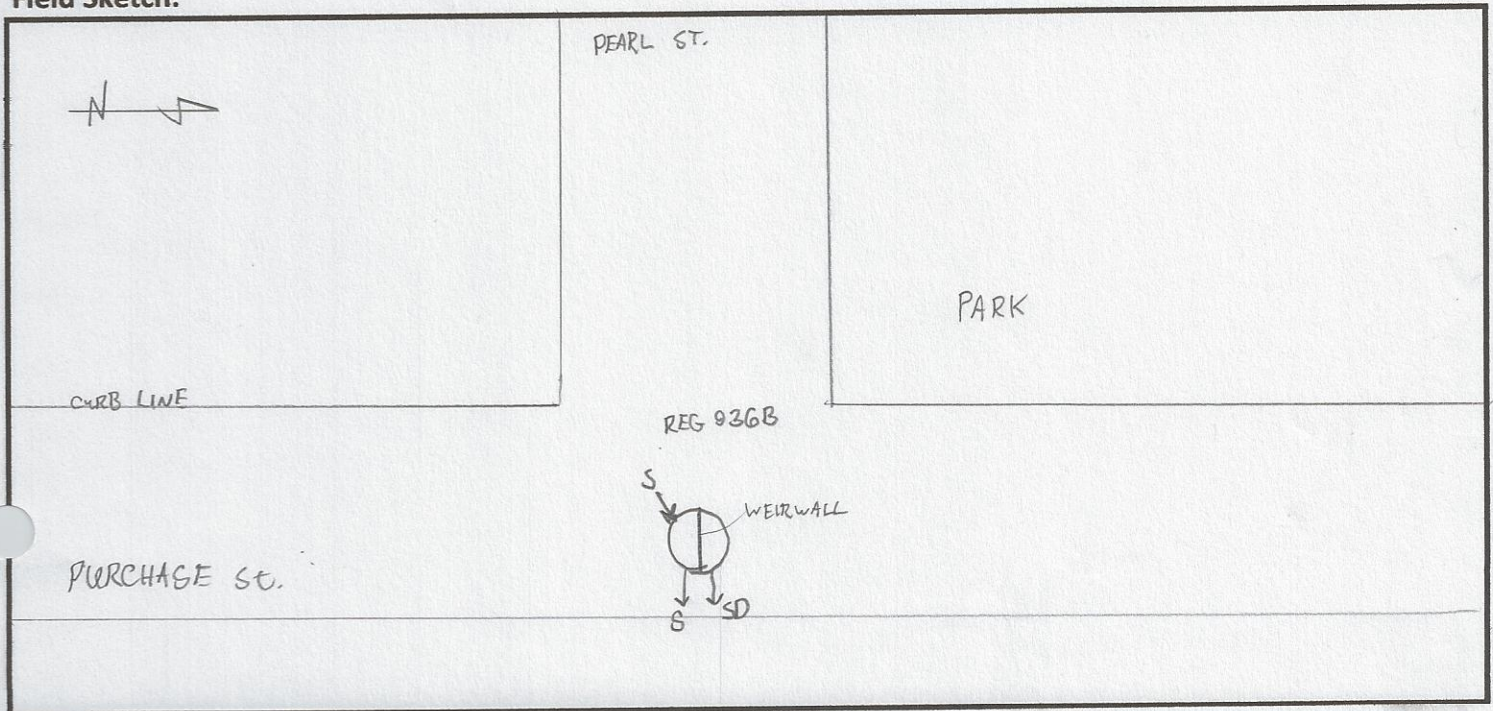

CSO FIELD PHOTOS

Structure#: REG 036 B

Location: At the Intersection of Pearl St and Purchase St.


Figure 1.



Figure 2.



Figure 3.

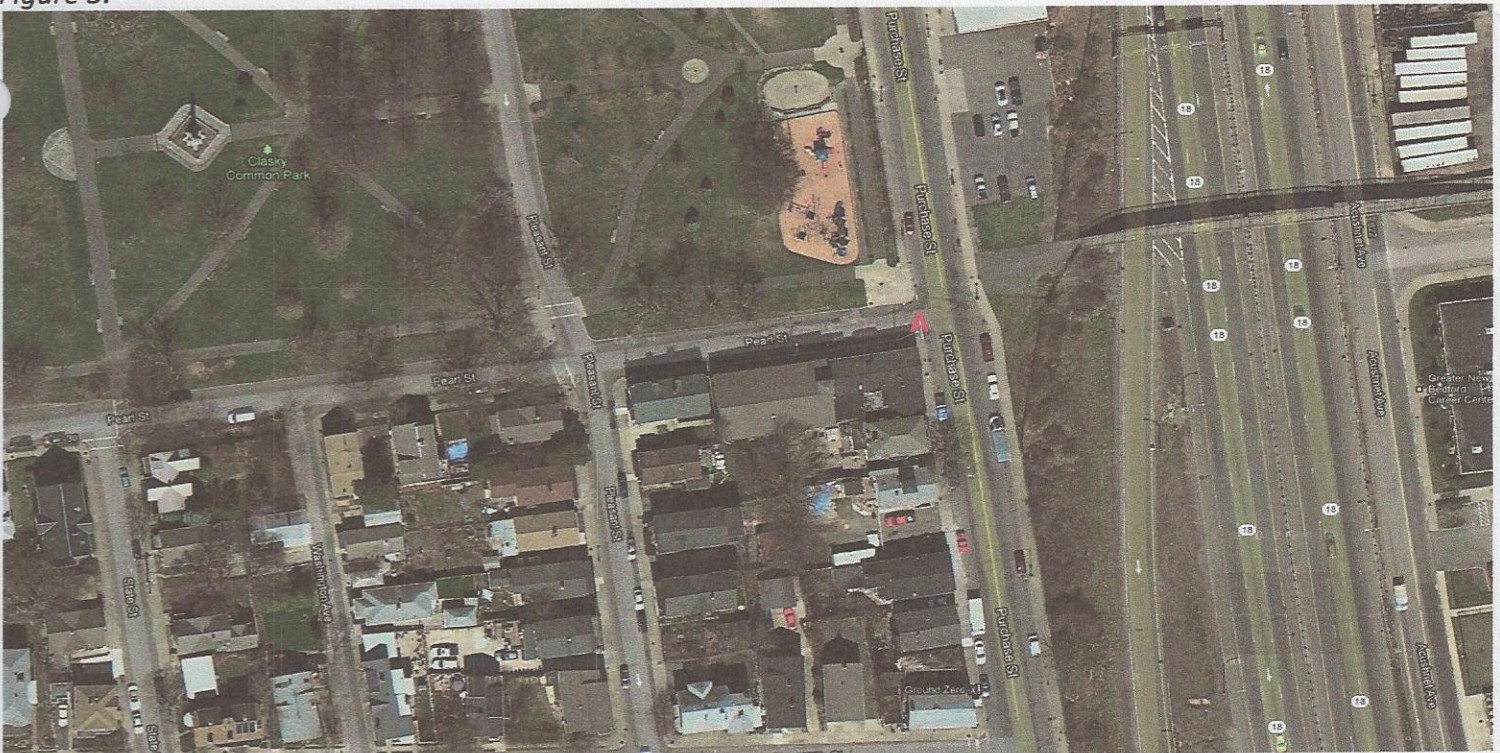

Descriptions

Figure 1: View of Regulator 036 B. Facing North. A- REG 036 B.

Figure 2: Inside view of manhole. A- Sewer; B- Weir Wall; C- Storm Drain.

Figure 3: Google Earth Image of location of Regulator 036 B. A- Reg 036 B.

PIPE

STREET

10559-19

Regulator 36 B

STREET

1379

1387

1395

8"
8"
10"


15" 42" RELIEF INT

3" SEWER

15" STORM
DRAIN

RAMP

56

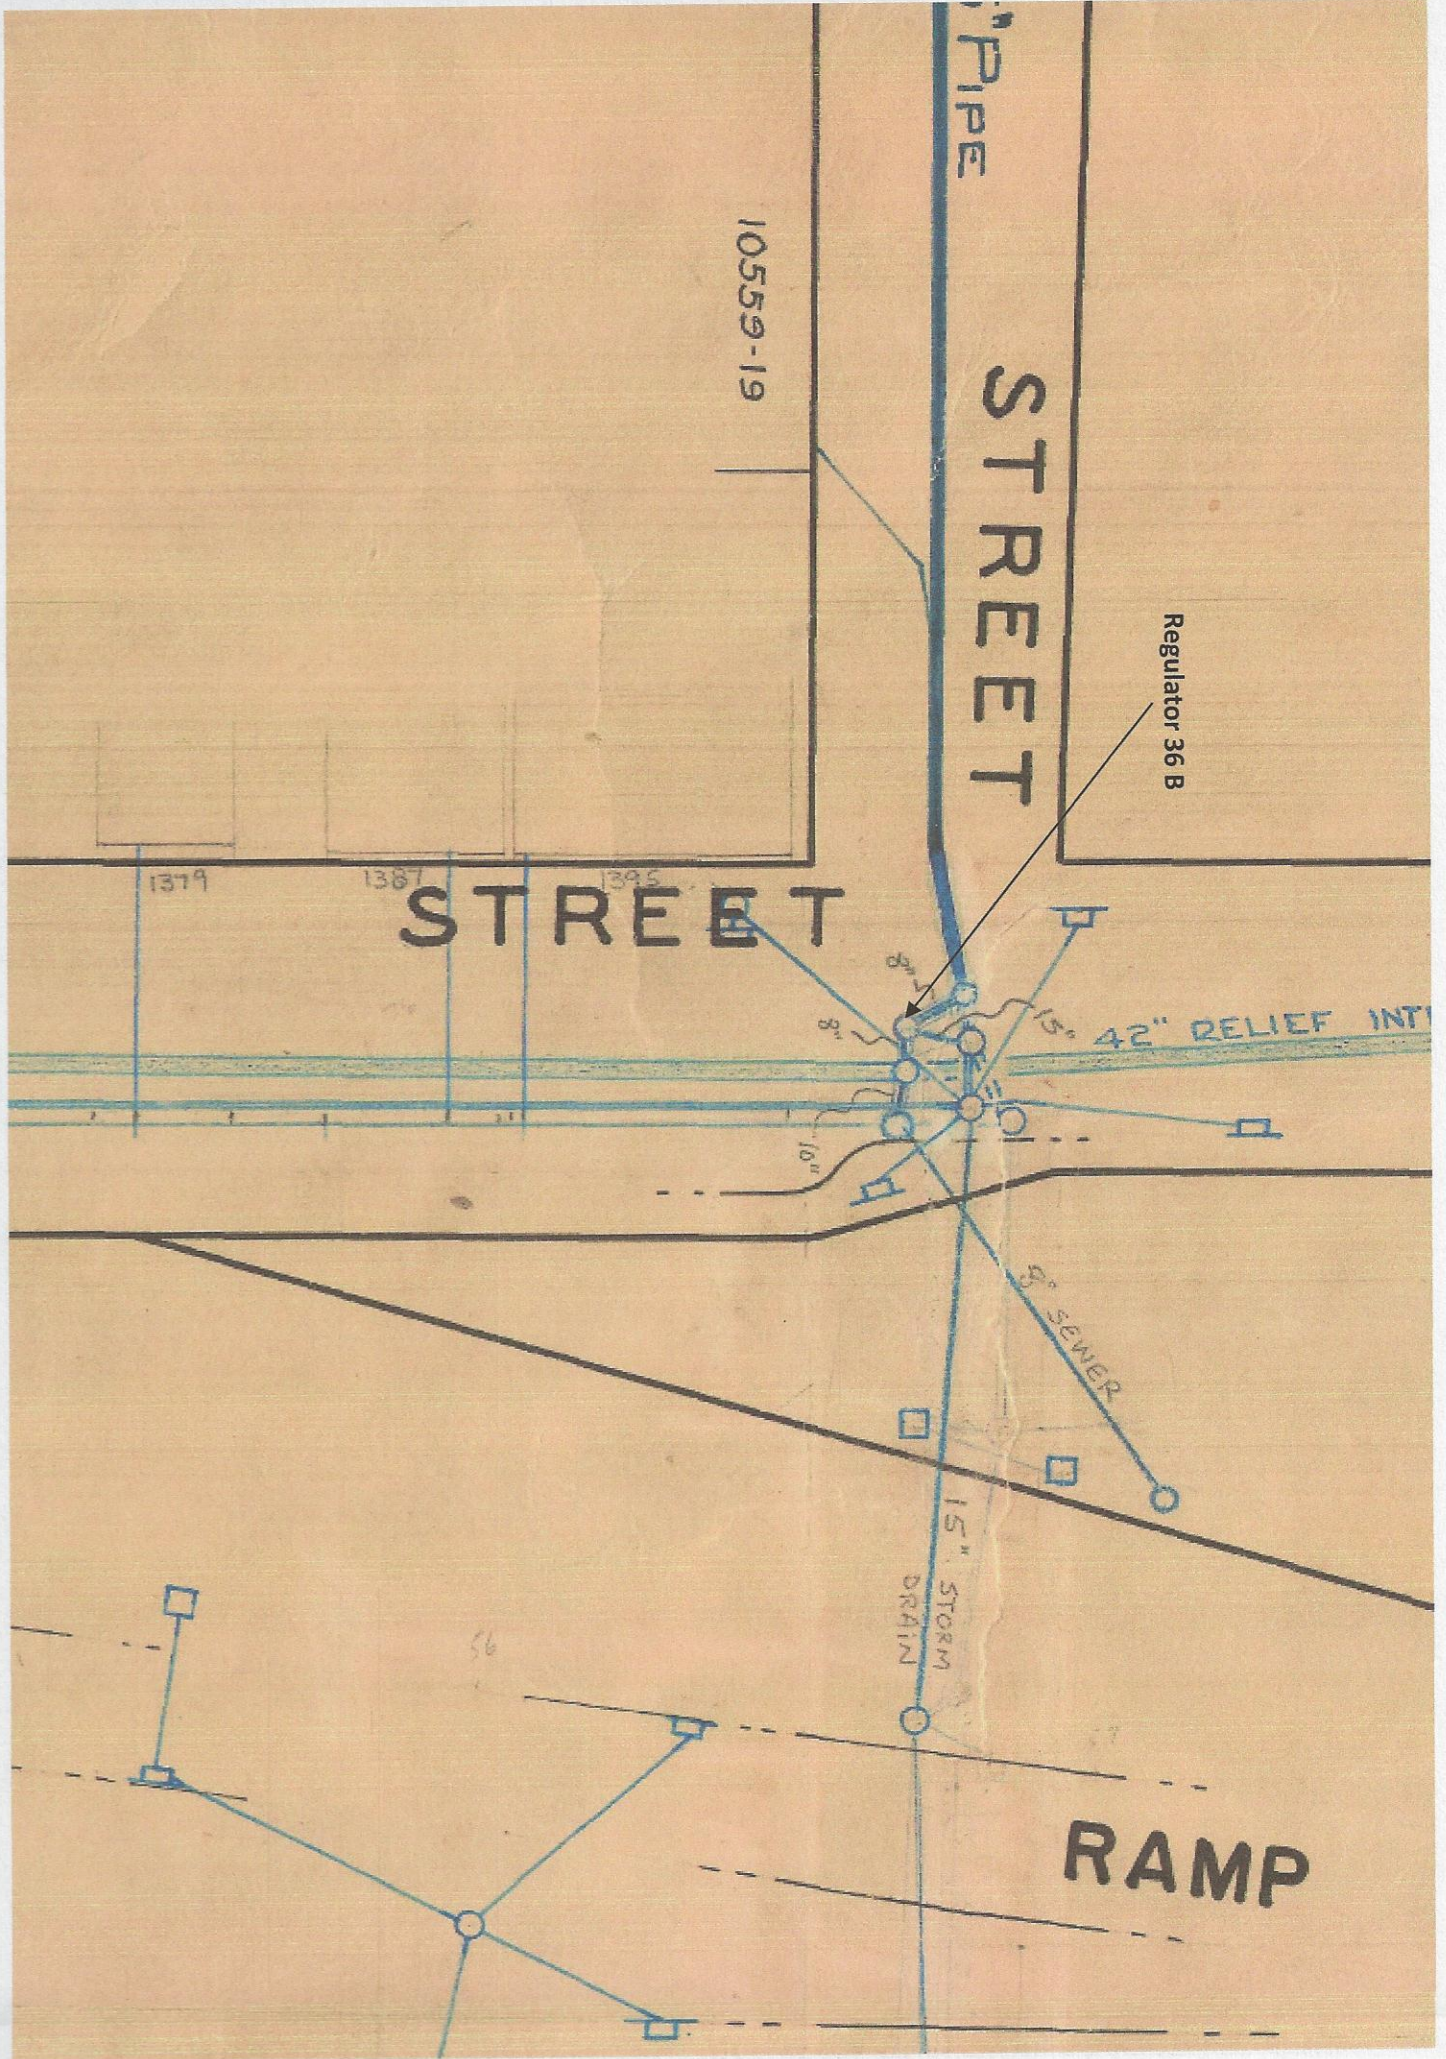

CSO/Regulator Repair Log

Structure #: Reg 036B

[illegible]