



R-036B Field Investigation 2/14/24

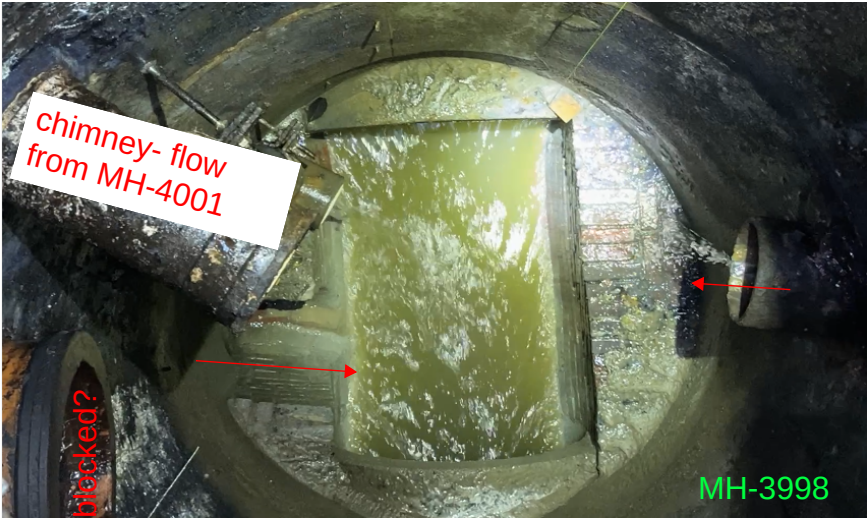

high level outlet acts as regulator structure in MH-4001

For most recent plan see B-622 (sheet 14)

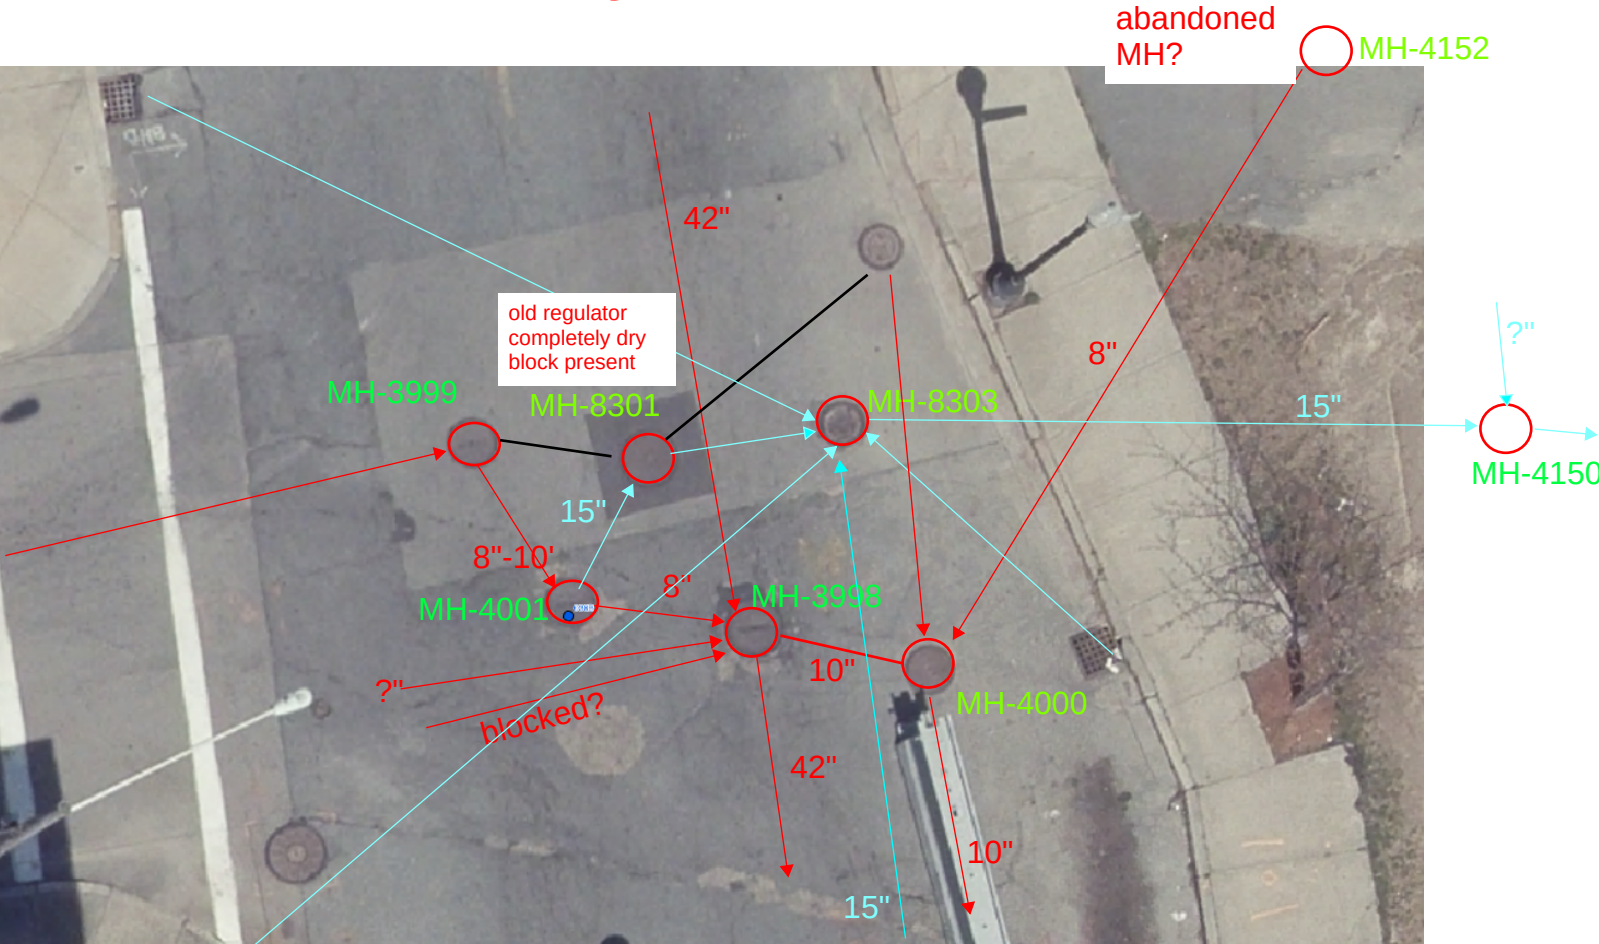