


New Bedford, Ma			Site I.D.	
Flow Monitoring Site Installation Report			041A	

Site Address / Location:	Belleville Ave at Belleville Road	Monitor Series	Location Type
Site Access:	Drive up on side of road	ECHO	Temporary
		Pipe Size (H x W)	Pipe Shape
		36x36	Circular



Manhole #	System Characteristics
	Commercial
Access	Traffic
Drive	Light

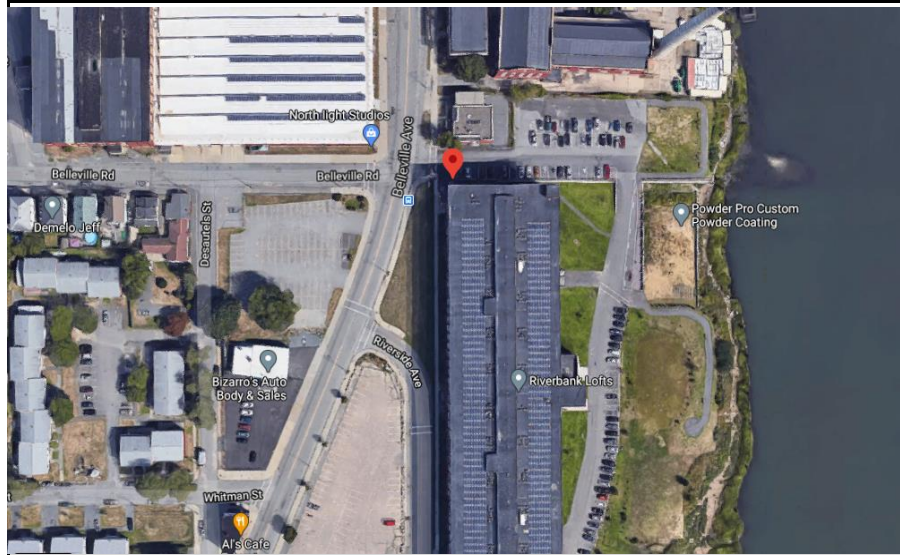

ADS Project Name:	New Bedford, Ma
ADS Project Number:	32673.52

Installation Information	
Installation Date:	Installation Type:
Thursday, February 18, 2021	Level Only
Monitoring Location (Sensors):	Monitor Location:
	Manhole
Sensors / Devices:	Pressure Sensor Range (psi)
ECHO Depth	
Installation Confirmation:	
Confirmation Time:	Pipe Size (HxW)
1:45:00 PM	36x36
Depth of Flow (Wet DOF) (in)	Range (Air DOF) (in)
Downlooker Physical Offset (in)	Measurement Confidence (in)
18	
Peak Velocity (fps)	Velocity Sensor Offset (in)
Silt (in)	Silt Type
0	
Hydraulic Comments:	
Manhole / Pipe Information:	
Manhole Depth (Approx. FT):	Manhole Configuration
8.75	CSO Flow Divider
Manhole Material:	Manhole Condition:
Concrete	Good
Manhole Opening Diameter (in)	Manhole Diameter (Approx.):
24	24
Manhole Cover	Manhole Frame
Concealed	Normal
Active Drop Connections	Air Quality:
	Good
Pipe Material	Pipe Condition:
Cast Iron Pipe	Good
Communication Information:	
Communication Type	Antenna Location
Wireless	Drilled Pavement / Concrete
Additional Site Info. / Comments:	
41.669142,-70.920322 OF Trigger: 18.75	