

CSO SPEC SHEET

Structure #: REG 041 A

Date: 09/19/2012
Insp. By: AK & AH

Location: At the Intersection of Belleville Ave and Belleville Rd.

Structure Type: Concrete Weir Wall

Regulator Type: Block Regulator

Structure DIM's: _____

Weir Dim's: _____

Size of Sewer Pipe: _____

Rim to Weir Wall: 10.7'

Size of Storm Drain Pipe: _____

Rim to Storm Drain Invert: _____

Sewer Direction: West to East

Rim to Top of Sewer (Normal Flow): 12.0'

Free Board: 1.3'

Over All Rating: (Circle One)

Poor


Fair

Good

Excellent

Comments: No Repairs Needed. Tide Water is going into the sewer side

Field Sketch:

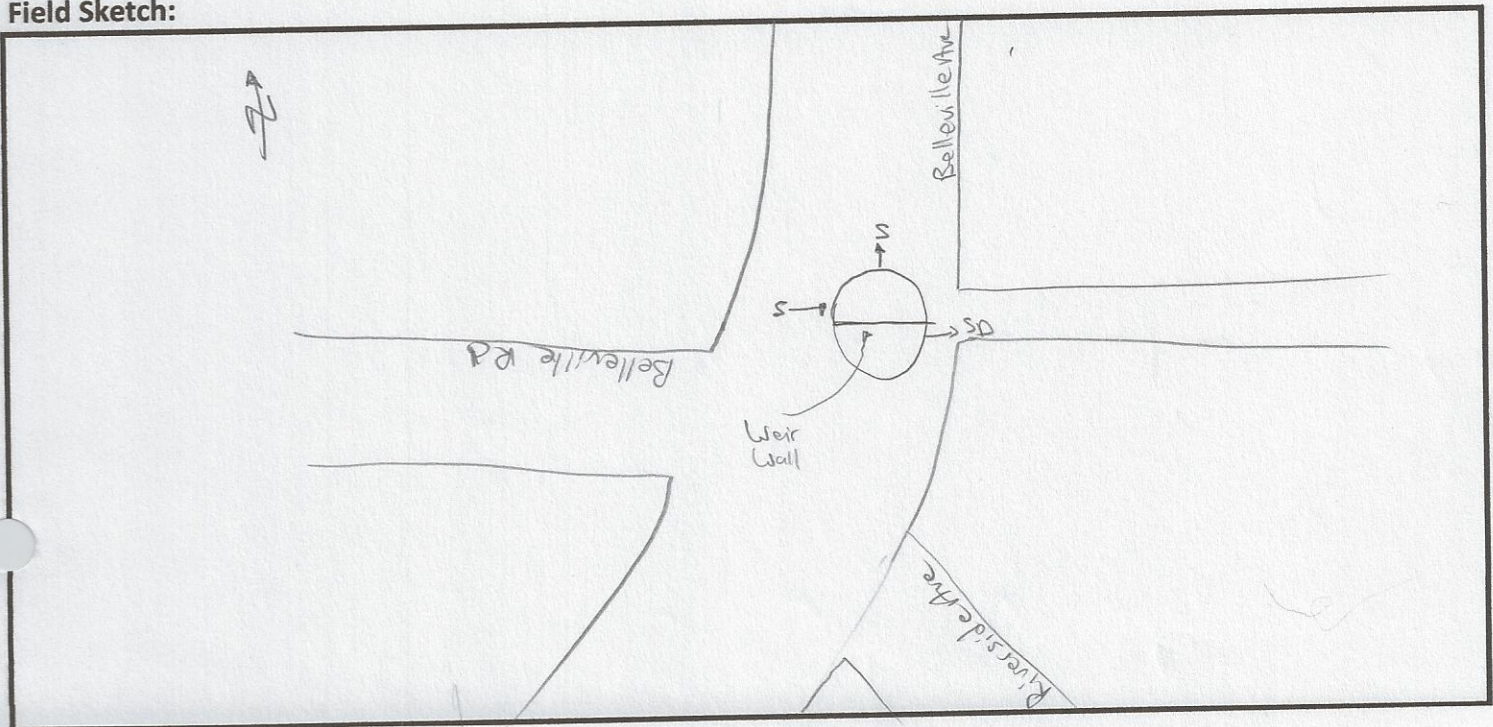

CSO FIELD PHOTOS

Structure#: REG 041 A

Location: At the Intersection of Belleville Ave and Belleville Rd.


Figure 1.



Figure 2.



Figure 3.

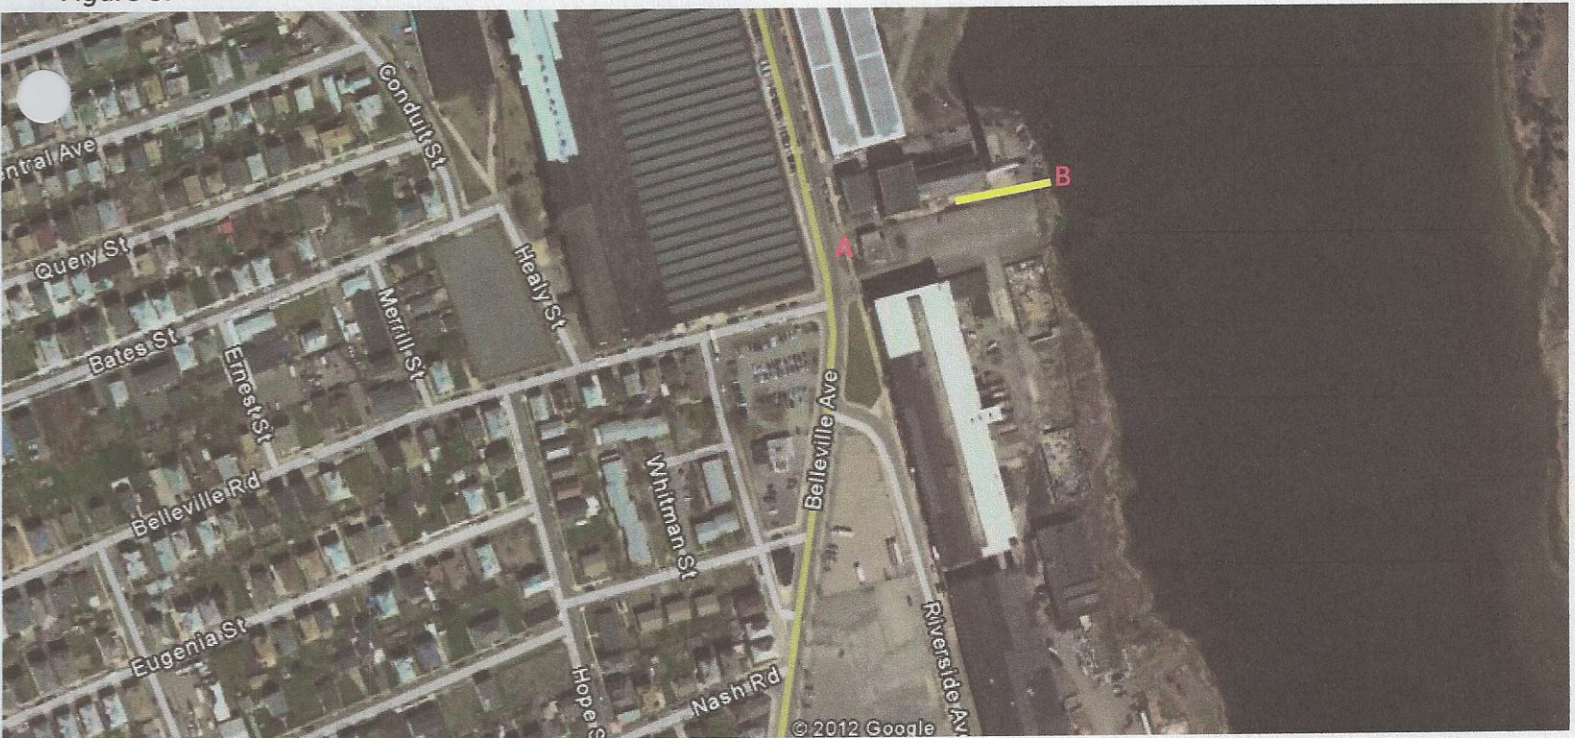


Descriptions

Figure 1: View of Regulator 041 A. Facing North.

Figure 2: Inside view of manhole. A- Sewer; B- Weir Wall; C- Storm Drain.

Figure 3: Google Earth Image of location of Regulator 041 A. A- Reg 041 A. B- CSO 041 Outfall.

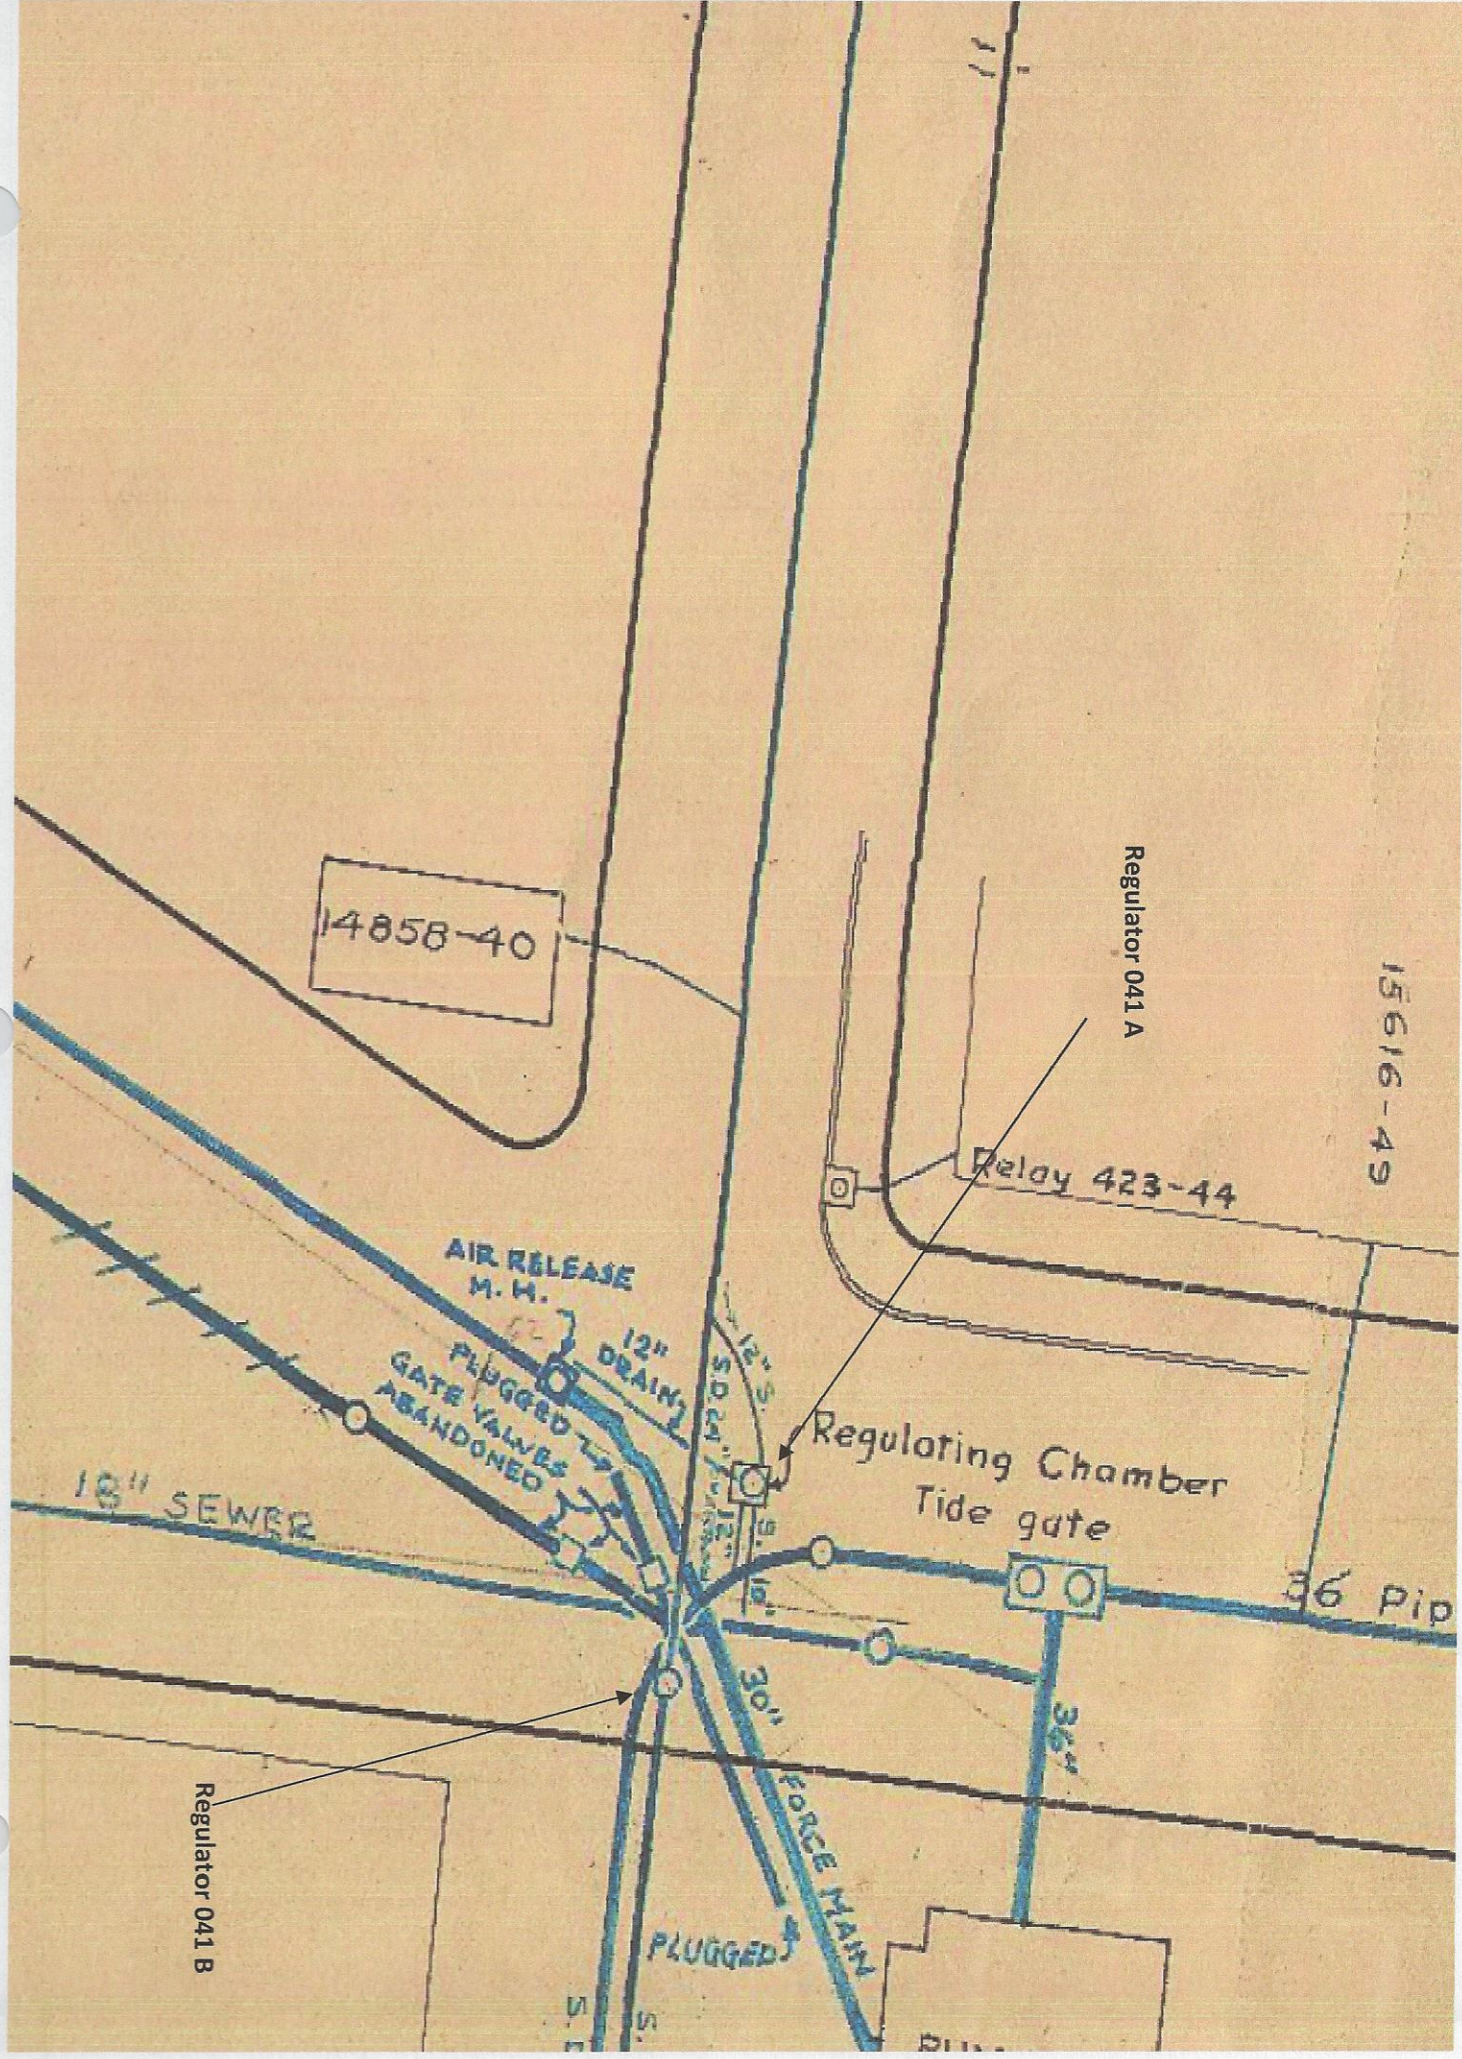

CSO/Regulator Repair Log

Structure #: Reg 041A

[illegible]