





BELLEVILLE
AVENUE


BELLEVILLE
ROAD

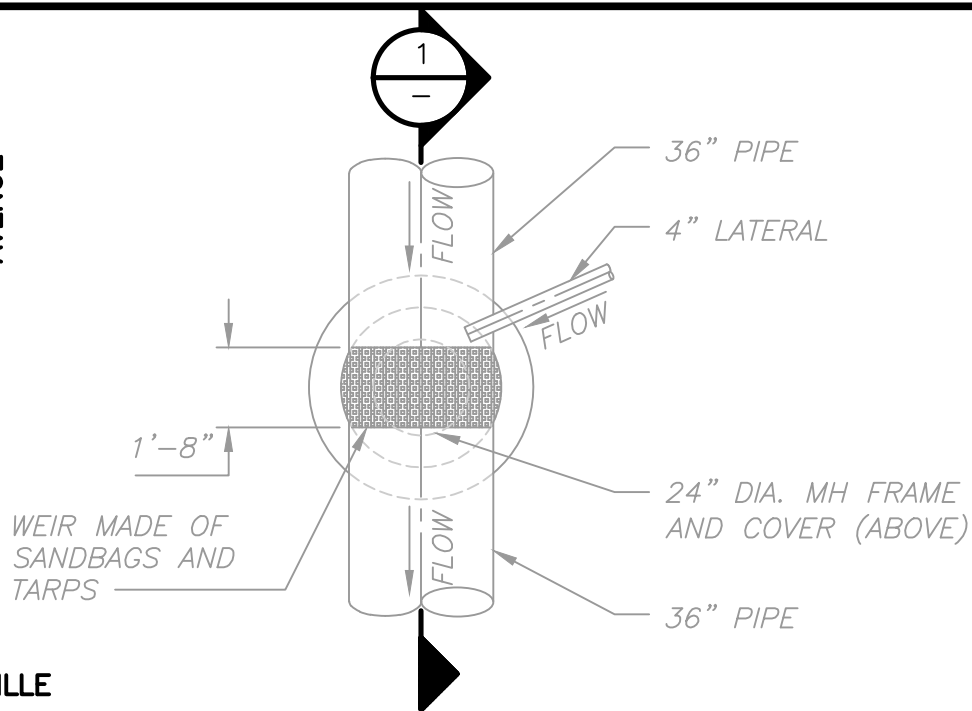

PLAN

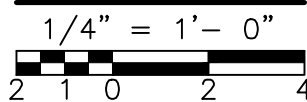

NOTE:
ELEVATIONS SHOWN ARE
IN NAVD1988 FT.

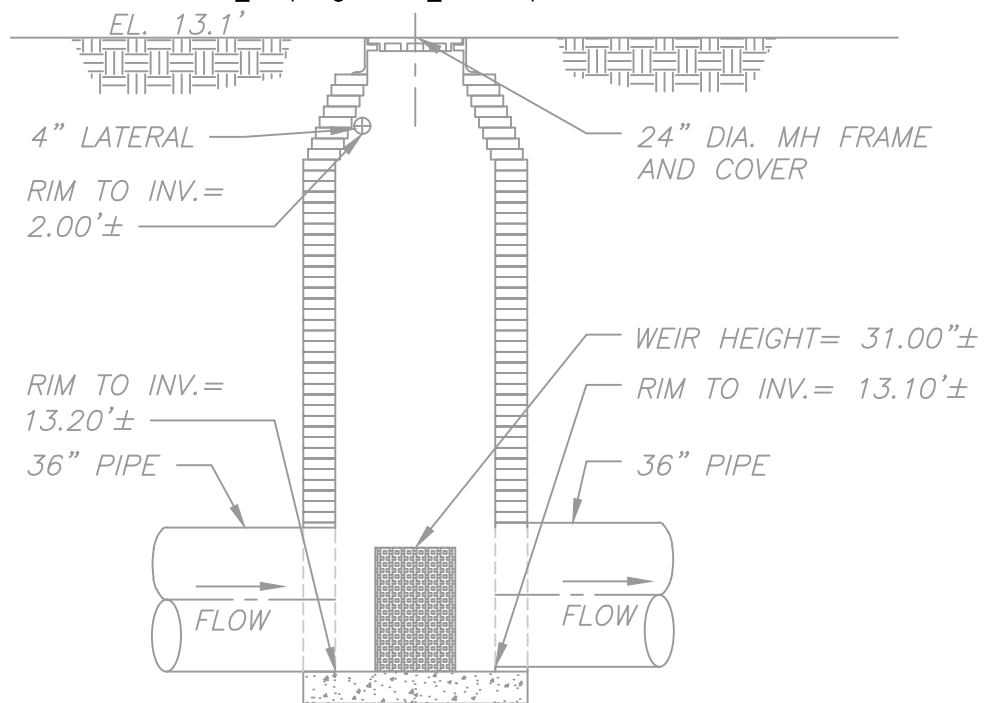

SECTION

1/4" = 1'-0"

