

## CSO SPEC SHEET

Structure #: REG 041 B

Date: 09/19/2012

Insp. By: AK & AH

Location: At the Intersection of Belleville Ave and Belleville Rd.

Structure Type: Concrete Weir Wall

Regulator Type: Block Regulator

Structure DIM's: \_\_\_\_\_

Weir Dim's: \_\_\_\_\_

Size of Sewer Pipe: \_\_\_\_\_

Rim to Weir Wall: 7.2'

Size of Storm Drain Pipe: \_\_\_\_\_

Rim to Storm Drain Invert: \_\_\_\_\_

Sewer Direction: West to East

Rim to Top of Sewer (Normal Flow): 8.2'

Free Board: 1.0'

Over All Rating: (Circle One)

Poor


Fair

Good

Excellent

Comments: No Repairs Needed.

Field Sketch:

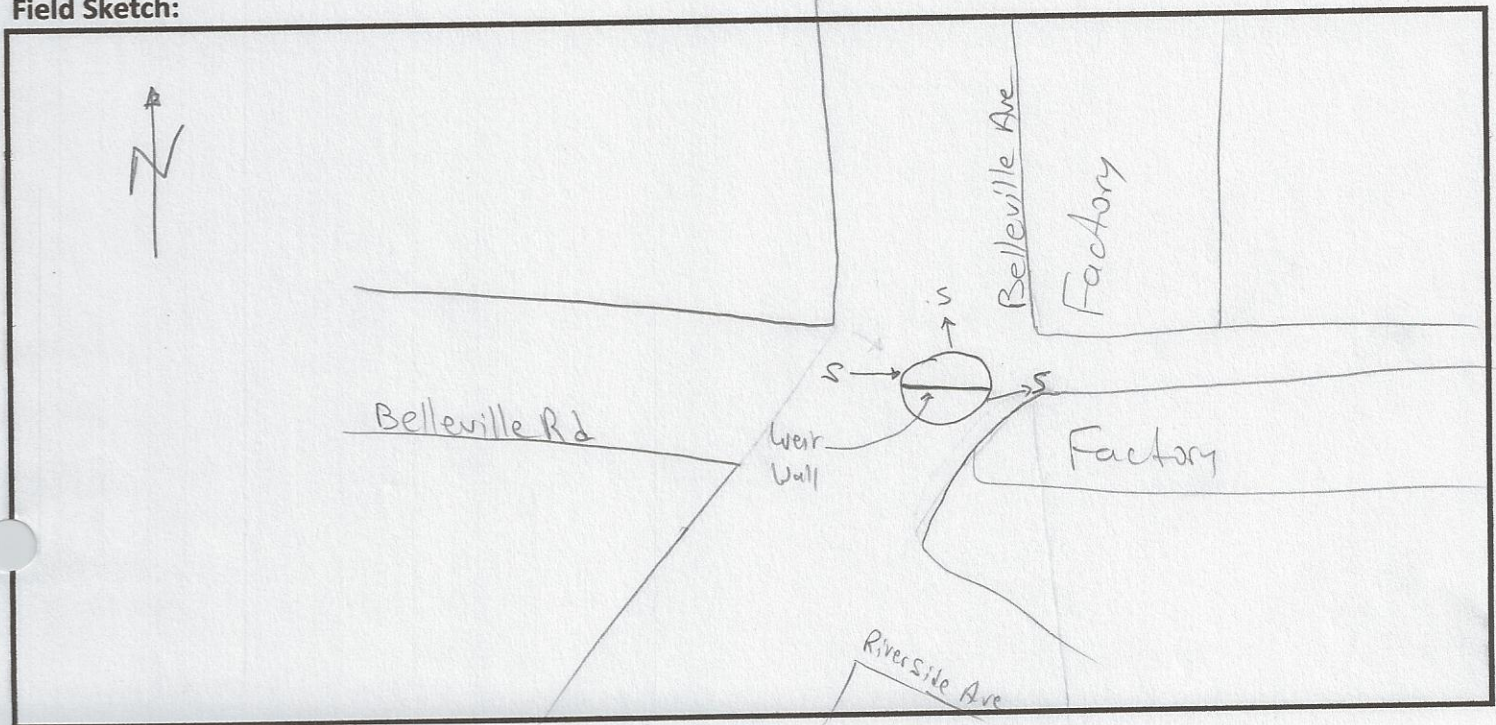



## CSO FIELD PHOTOS

Structure#: REG 041 B

Location: At the Intersection of Belleville Ave and Belleville Rd.

Figure 1.



Figure 2.


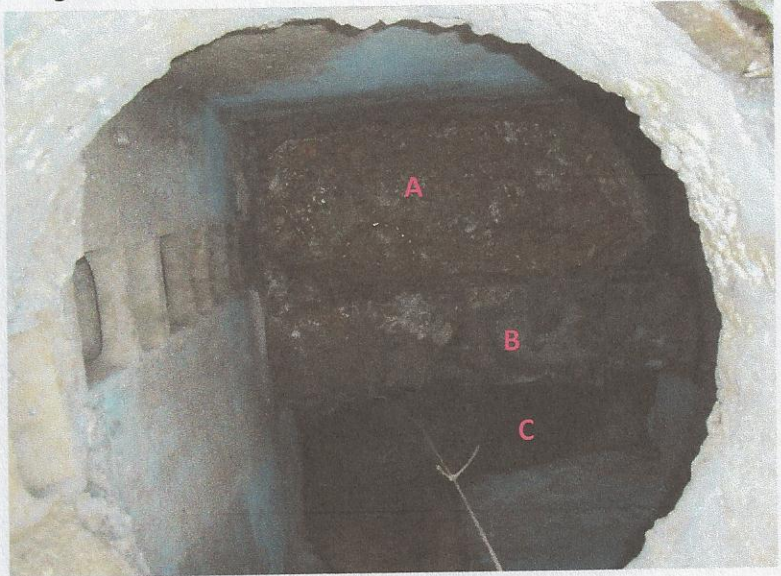


Figure 3.

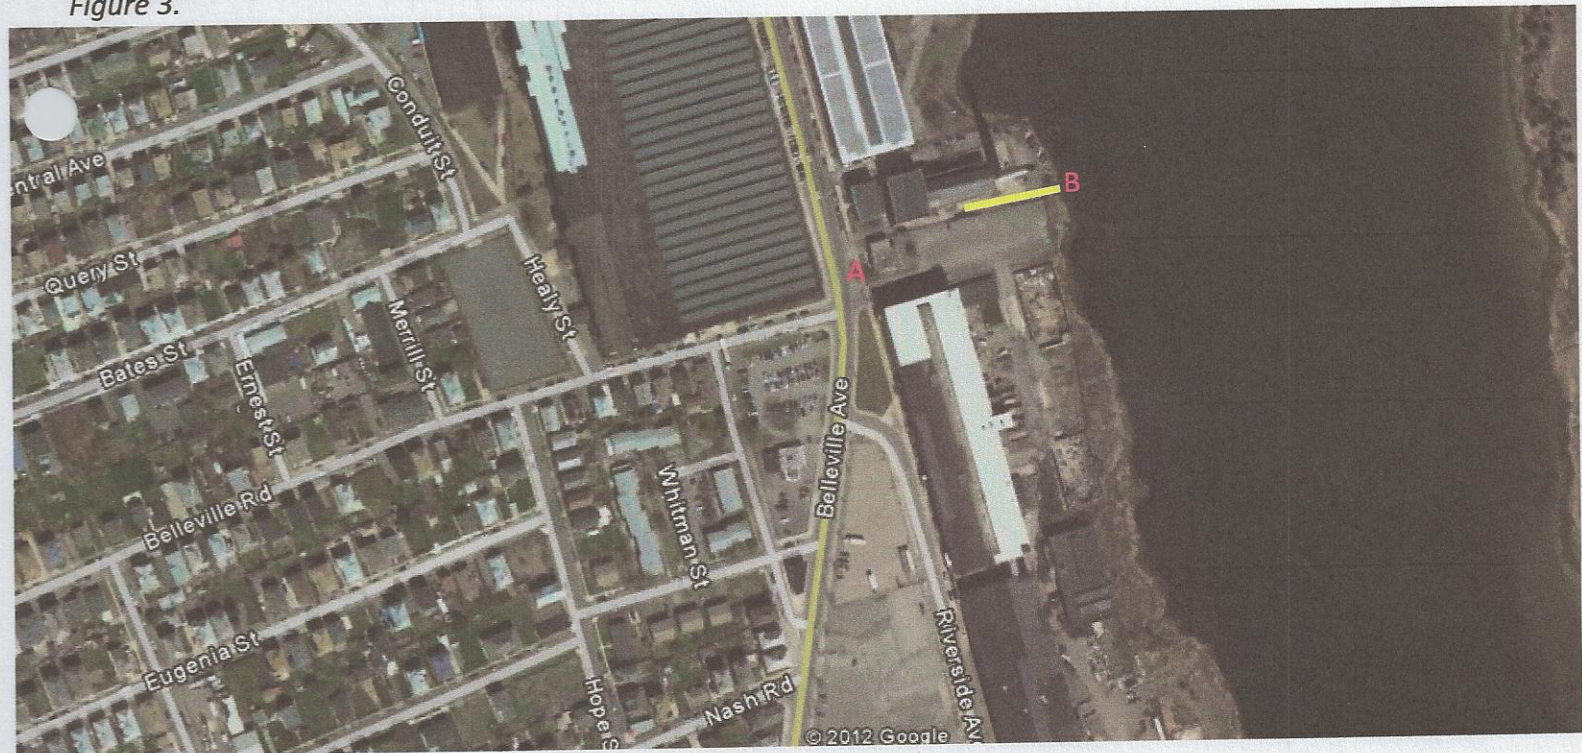


### Descriptions

**Figure 1:** View of Regulator 041 B. Facing North.

**Figure 2:** Inside view of manhole. A- Sewer; B- Weir Wall; C- Storm Drain.

**Figure 3:** Google Earth Image of location of Regulator 041 B. A- Reg 041 B. B- CSO 041 Outfall.



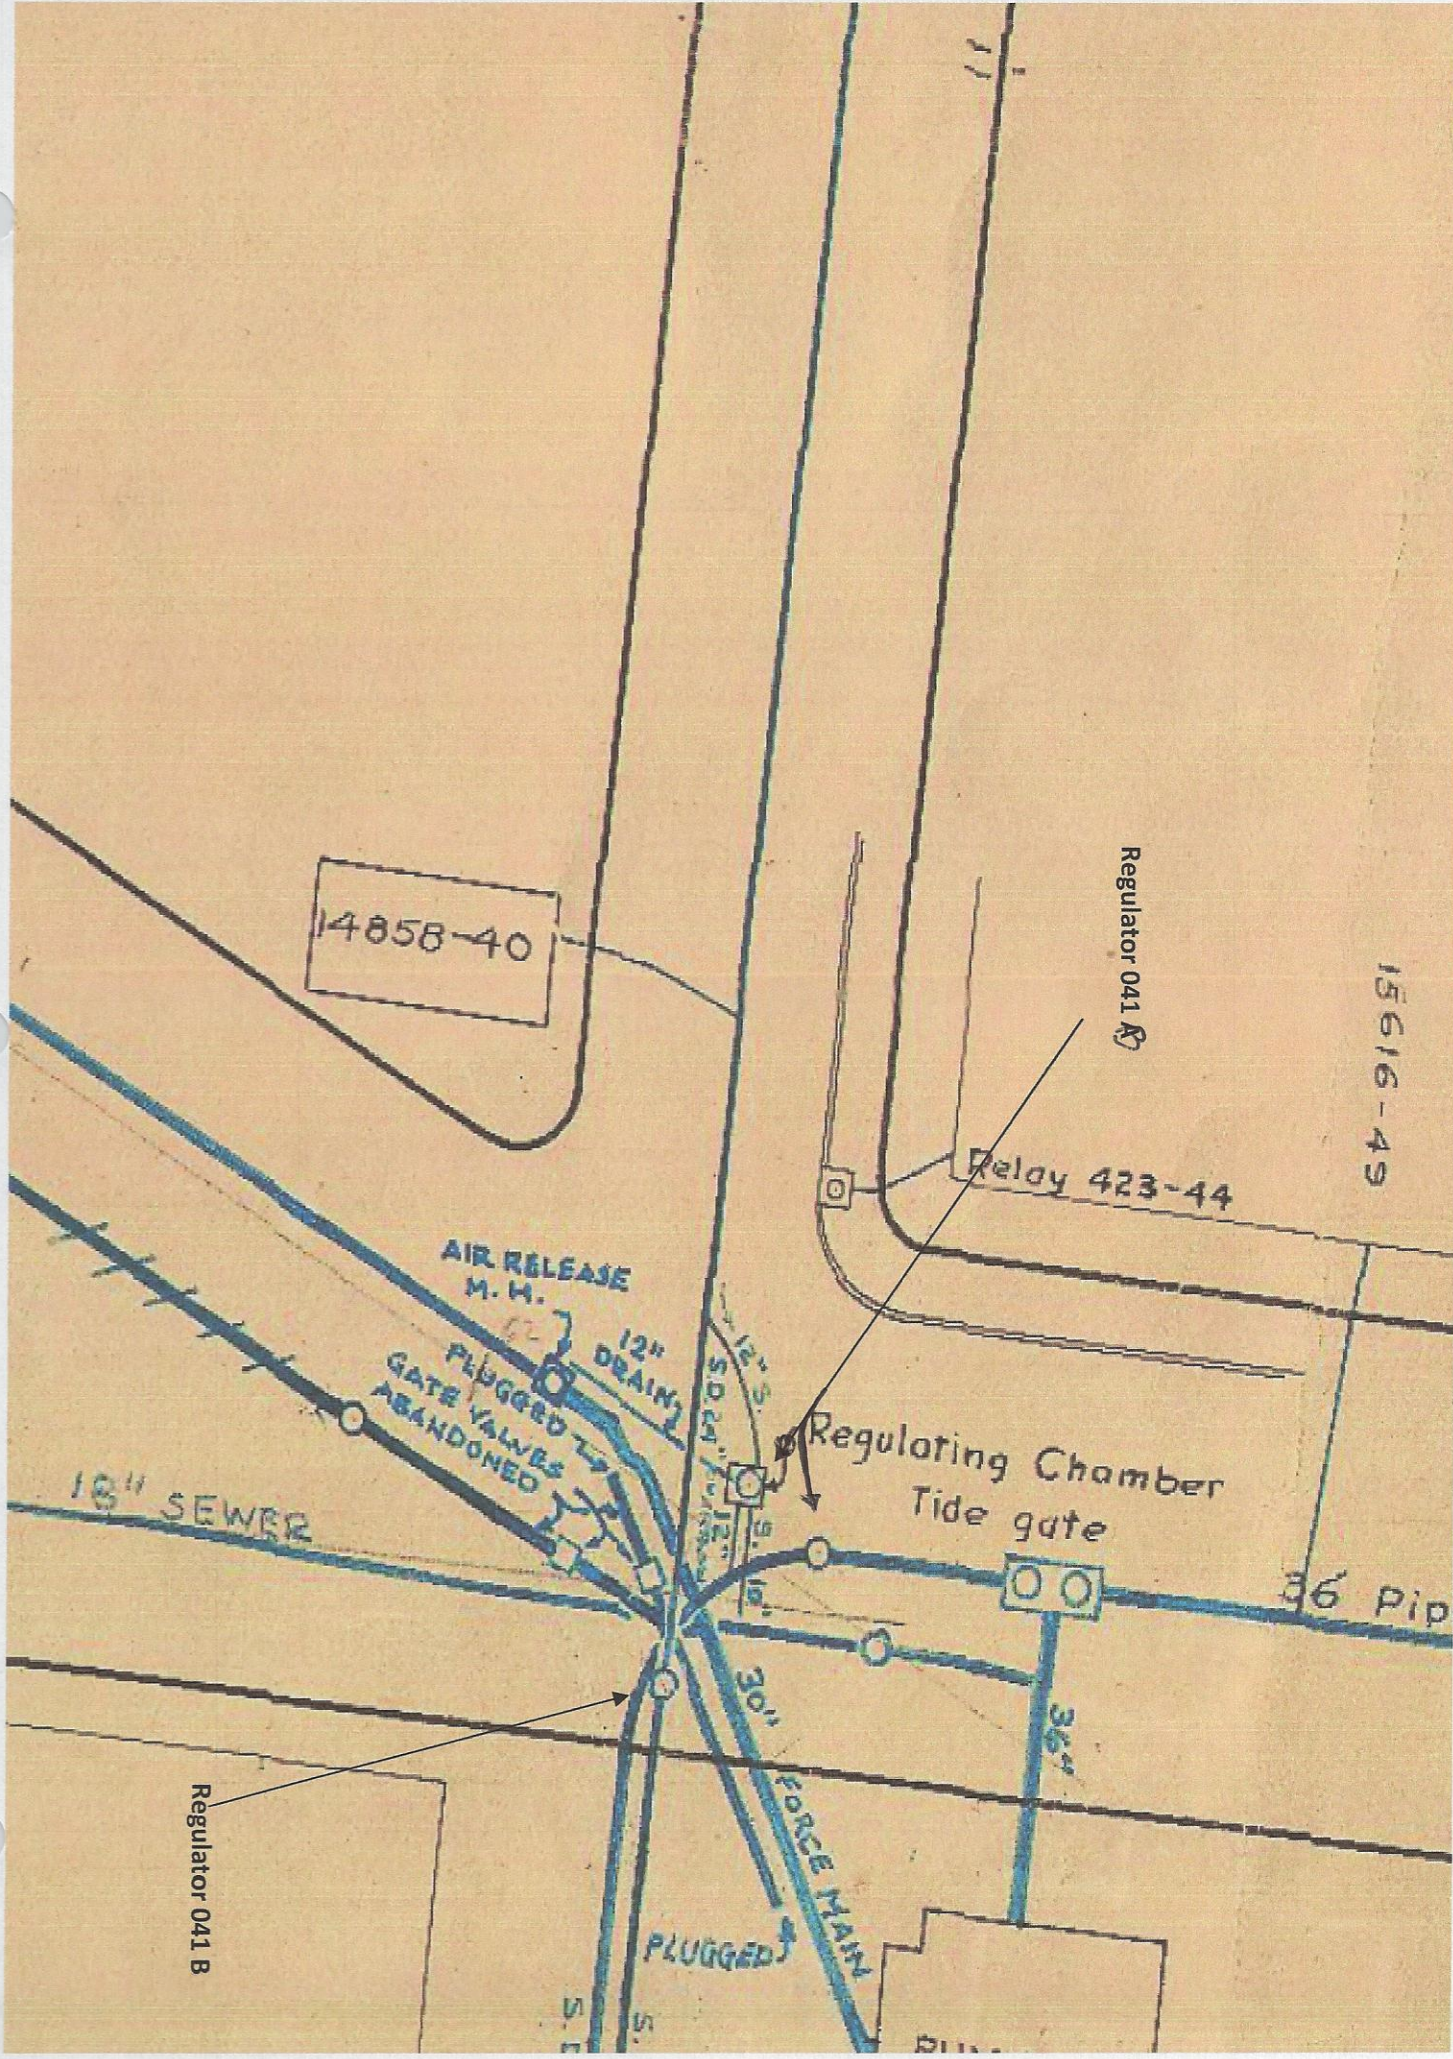



## CSO/Regulator Repair Log

Structure #: Reg 041B

[illegible]