

HATHAWAY

BELLEVILLE

RIVERSIDE

AVENUE

AVENUE

M.H. Regulating Chamber

M.H.

M.H. 1.8' n. of n.l. of south bldg. Manomet Mill


Weir M.H.
M.H.s. Regulating Chamber
36" into Pumping Station

Note: See revised general (white paper) drawings of Intercepting Sewer showing sewer in Riverside Ave. as constructed.

CITY OF NEW BEDFORD
INTERCEPTING SEWER SYSTEM
RIVERSIDE AVE. SEWER
MAY 1917

CONSULTING ENGINEER

SCALES { HORZ. 1"=40'-0"
VERT. 1"=4'-0"

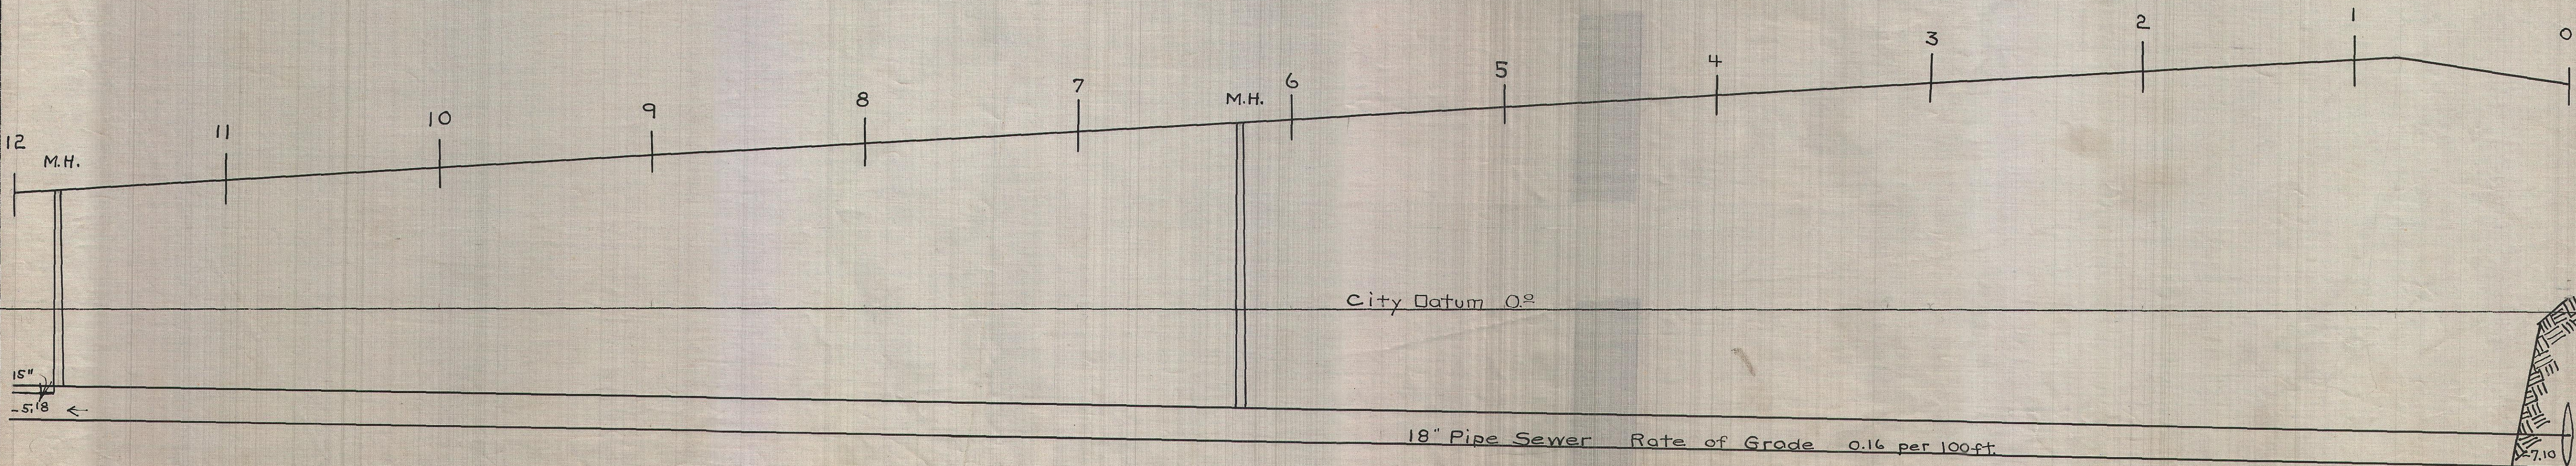

36" Sewer into Pumping Station