


New Bedford, MA			Site I.D.	
Flow Monitoring Site Installation Report			R-041B	

Site Address / Location:	618 Belleville Ave	Monitor Series	ECHO	Location Type	Temporary
Site Access:	Drive	Pipe Size (H x W)	36.00x36.00	Pipe Shape	Circular



Manhole #	System Characteristics
	Residential
Access	Traffic
Drive	Medium

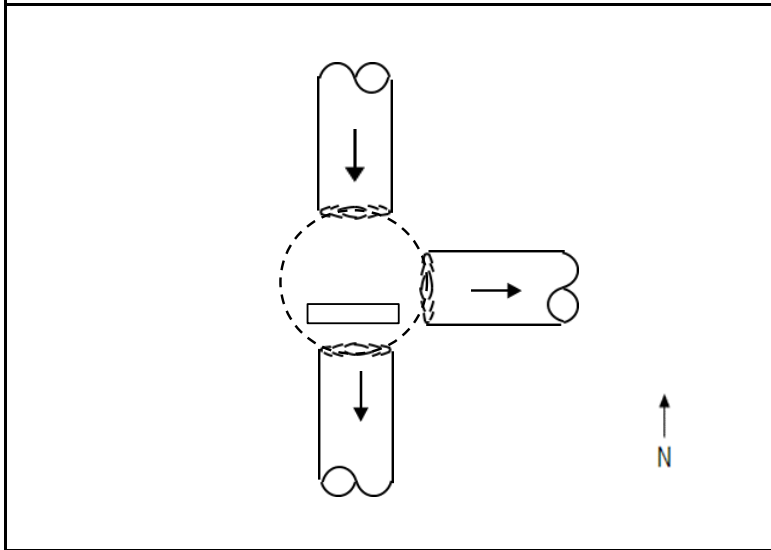

ADS Project Name:	
ADS Project Number:	

Installation Information	
Installation Date:	Installation Type:
Thursday, June 1, 2023	Level Only
Monitoring Location (Sensors):	Monitor Location:
	Manhole
Sensors / Devices:	Pressure Sensor Range (psi)
ECHO Depth	
Installation Confirmation:	
Confirmation Time:	Pipe Size (HxW)
10:45:00 AM	36.00x36.00
Depth of Flow (Wet DOF) (in)	Range (Air DOF) (in)
Downlooker Physical Offset (in)	Measurement Confidence (in)
0	0.25"
Peak Velocity (fps)	Velocity Sensor Offset (in)
	0
Silt (in)	Silt Type
0	0
Hydraulic Comments:	
Manhole / Pipe Information:	
Manhole Depth (Approx. inches):	Manhole Configuration
229.5	Common Trench
Manhole Material:	Manhole Condition:
Concrete	Good
Manhole Opening Diameter (in)	Manhole Diameter (Approx.):
18	18
Manhole Cover	Manhole Frame
Concealed	Normal
Active Drop Connections	Air Quality:
No	Good
Pipe Material	Pipe Condition:
Vitrified Clay Pipe	Good
Communication Information:	
Communication Type	Antenna Location
Wireless	Drilled Pavement / Concrete
Additional Site Info. / Comments:	