

Nov. 18, 1955

#24713

Manuel G. Costa

E.S. Morris St., N x Ludlow St.

Please install $3/4$ " City Meter &
 $3/4$ " Copper service to supply bungalow. To
be laid with drain in sidewalk. Tap main in
Ludlow St. Charge actual cost. Taker to
supply copper pipe.

Measure of $3/4$ " curb stop:


W x W line House #953 Ludlow Street	31.1
W x E " Morris Street	5.5
North line Ludlow St. opposite	
Bound Stone	

Work done December 22, 1955

(over)

32 ft. of 3/4" copper tubing type K, soft.....	\$ 23.68
1-3/4" copper stop, fig. 415 - Red Hed.....	\$
1-3/4" corporation, fig. 438 - Red Hed.....	\$
1 C. I. stop box, complete.....	\$
Use of compressor.....	\$ 3.--
Use of tapping machine.....	\$ 1.--
Carting.....	\$ 2.--
Labor.....	\$ 24.12

This service was laid in the middle of the sidewalk with the drain.

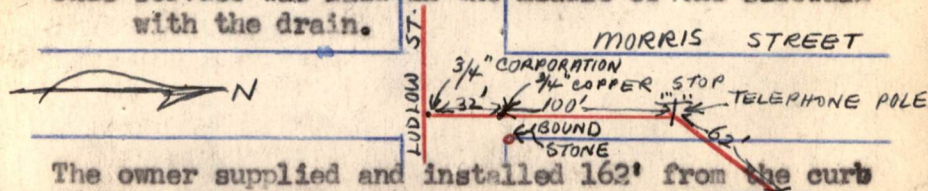

The owner supplied and installed 162' from the curb stop to inside the building.

#953

HOUSE