

June 20, 1956

#24886

Mass. Dept. of Public Works
S.S. Fairhaven Bridge, E x Fish Island

Please install 1" City Meter & 1"
Copper service to supply operator's house.
Connect hydrant branch on bridge E.S. Fish
Island. City to furnish tap, stop, and stop
box only.

E x Center of hydrant	6.2
E x E line 40 ft. way south (curb)	246.2
E x 1st. hydrant x drawbridge	6.2
N x S Iron Rail	7.0

(see sketch on back of service card)


Work done June 20, 1956

(over)

1-1" Corporation, #1200 - Welsbach Corp.....	
1-1" Copper stop, fig. 415 - Red Hed.....	
Use of tapping machine.....	1.50
1 Cast Iron stop box, complete.....	
Carting.....	2.--
Labor.....	12.67

DAVID DUFF CO.

OWNER SUPPLIED 125 FT. OF 1" COPPER TUBING
TYPE K, 50 FT. FROM TAP IN HYDRANT PIPE TO
INSIDE BLDG.

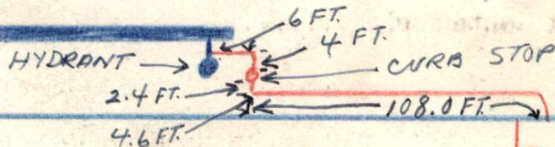

SOCONY CO.

BUILDING