

Expires 5/11/18

SERVICE

33937

Presidential

NEW BEDFORD WATER WORKS

APPLICATION FOR SERVICE AND METER

NEW BEDFORD

5/11/2017

I HEREBY ACKNOWLEDGE the receipt of a copy of the Regulations prescribed in the Ordinance of the City, for the use of Water, and I request that the water may be furnished through a

1" inch copper meter at 196 Worcester St (E.S.)
270' S x BROCKTON St.

at such rates as may from time to time be established by the City.

I hereby agree to pay promptly the bill for the Service pipe laid down for my premises, and to pay all dues for water, and I agree to conform to the said Regulations and to all provisions of the Water Ordinances, until written notice is given by me or my agent to cut off the supply.

P. 127A

X. Rosa Mark

DPM Development

L. 301

70 Lanbath Street

Sewer # 245B

TELEPHONE (508) 993-0381

NB MA, 02745

Service laid _____ Size and kind of pipe _____

From _____ St.

Turned on _____ Meter Set _____

Reading _____ Location _____

Building rates _____ Paid _____

Cost of Service \$ 495.00 chkr # 7020 Paid _____

31-727

S - X s Line	Brockton St	275.0'
W x E Line	House	11.0'
S x N Line	House	23.0'
N x S Line	House	12.0'
W x W Line	House	32,5'

Main to Prop Line 31.0'

Pipe inside Property 25.0'


Picked up Couplings

Rose M...


127A-48
N/F
VILANRE
619 CHURCH ST

127A-47
N/F
PIRES
611 CHURCH ST

127A-45
N/F
MARK COSTA
LIVING TRUST
609 CHURCH ST

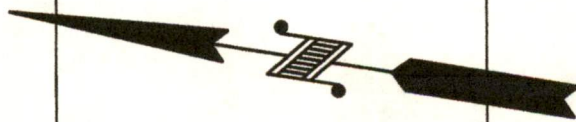



127A-19
N/F
P & I REALTY
TRUST CORP.
104 WORCESTER ST

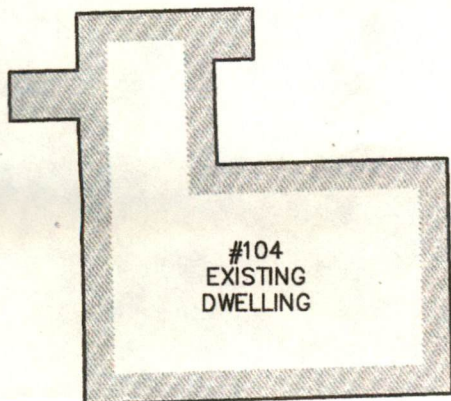

LOT 5
8,013± SF

EXISTING
FOUNDATION
TOF: 107.40'

127A-18
N/F
MIRANDA
94
WORCESTER
ST

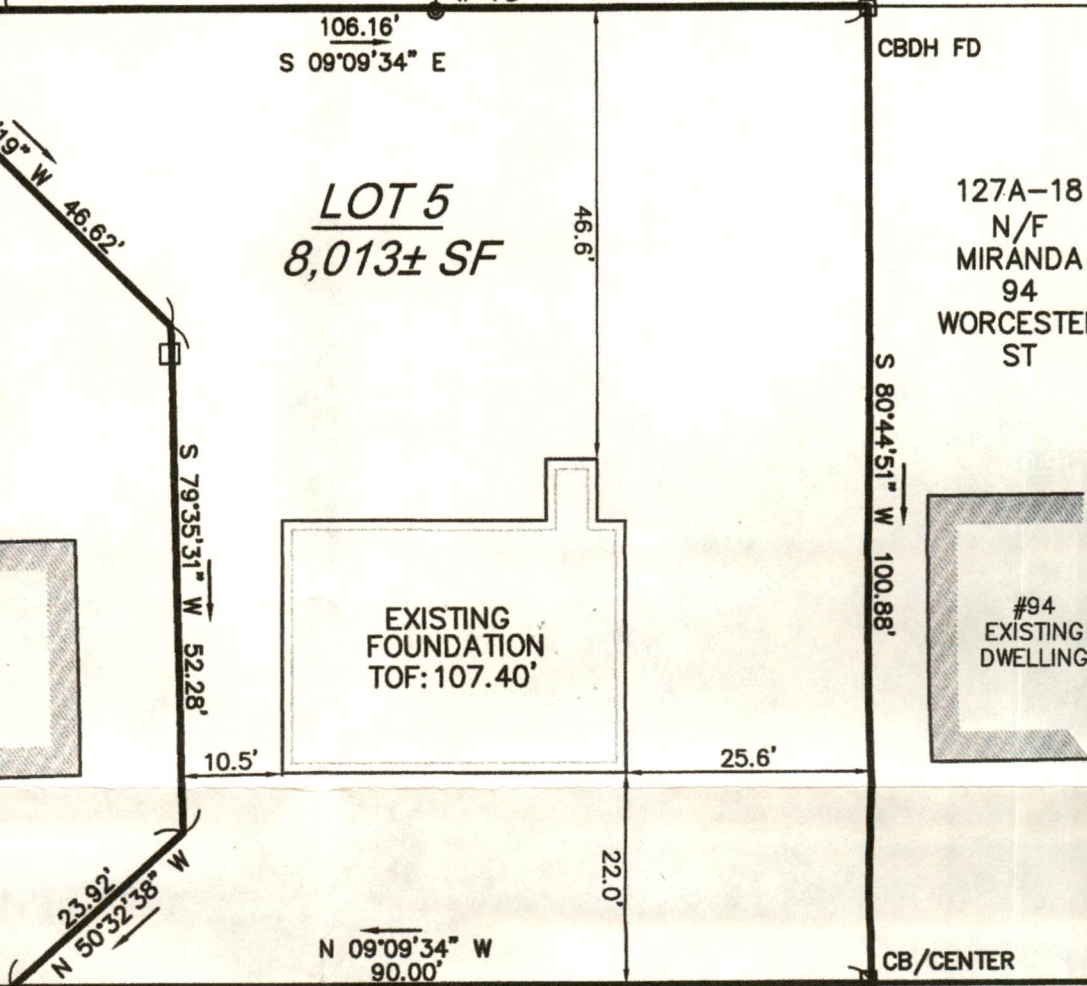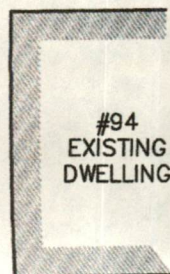


WORCESTER STREET
(PUBLIC - 50' WIDE)

AS BUILT FOUNDATION PLAN - MAP 127A LOT 19

LOT 5 - WORCESTER ST.

IN

NEW BEDFORD, MA.

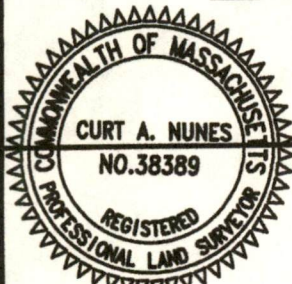

I CERTIFY THAT THE FOUNDATION SHOWN
HEREON, AS BUILT, CONFORMS TO THE CITY
OF NEW BEDFORD ZONING SETBACK
REQUIREMENTS.

PROFESSIONAL LAND SURVEYOR

DATE

DATE: MAY 5, 2017

SCALE: 1" = 20'

ROMANELLI ASSOCIATES INC.
PROFESSIONAL LAND SURVEYORS

1162 Rockdale Ave. New Bedford, MA 02740
Phone (508) 995-0100 - (508) 995-6678

WWW.ROMANELLI-INC.COM



JN 16-003

DISPLAY PERMIT IN A CONSPICUOUS PLACE ON THE PREMISES



Commonwealth of Massachusetts

City of New Bedford

133 William Street New Bedford, MA 02740

WATER SERVICE PERMIT



Date: 8/28/2017

No. **W-17-42**

Permit Fee: \$495.00

Service Location: 96 WORCESTER ST

Owner Name: DANIEL MONIZ

Owner Phone #: (508) 993-0381

Type of Occupancy: Residential

Type of Work: Water - Domestic New 1"

Work Description: service#33937

P.127A

Worcester St ES 270' S x Brockton St

**assigned #96 Worcester St
sewer#24512**

Contractor

Name: Robert J. Canessa Certificate #: _____ Type of Business : DPI - Other

Address: P. O. Box 51643 City/Town/State: New Bedford MA Phone #: (508) 998-

Type of Service Pipe Size Trench Length: **0.00**

Fire Service _____

Domestic Service _____

Estimated consumption of water

Estimated average daily consumption 0.00 gallons

Cross Connection? **No**

Estimated maximum day consumption 0.00 gallons

Right of Way? **No**

Are lawn sprinklers and/or lawn irrigation proposed on site? **No**

Meter Impact? **No**

Estimated fire flows required for the project site: 0.00

Street Opening Permit Required? **No**

Does the project require a fire suppression system? **No**

Required minimum static pressure for the proposed project site 0.00

Call Phone: (781) 942-9077 For Inspection