

- VOID -

SERVICE 34132

EXP. 6-9022
NEW BEDFORD WATER WORKS

APPLICATION FOR SERVICE AND METER

NEW BEDFORD 6-9021

I HEREBY ACKNOWLEDGE the receipt of a copy of the Regulations prescribed in the Ordinance of the City, for the use of Water, and I request that the water may be furnished through a

1 inch Copper meter at East side Herman Melville Blvd. South

P. 72 h. 293

Wamsutta St (Sec of assessor lot 293)

at such rates as may from time to time be established by the City. 355 ft south Wamsutta St

I hereby agree to pay promptly the bill for the Service pipe laid down for my premises, and to pay all dues for water, and I agree to conform to the said Regulations and to all provisions of the Water Ordinances, until written notice is given by me or my agent to cut off the supply.

temporary trailer

Tisbury Towing + Transportation 188 Birch Road,
Tisbury, MA 02568

TELEPHONE 508-693-0990

Service laid RBCur Company

Size and kind of pipe 1

From 16" water main on Herman Melville Blvd

Turned on

Meter Set

Reading

Location

Building rates

Paid


Cost of Service

\$ 500.00

Paid

3445

31-727

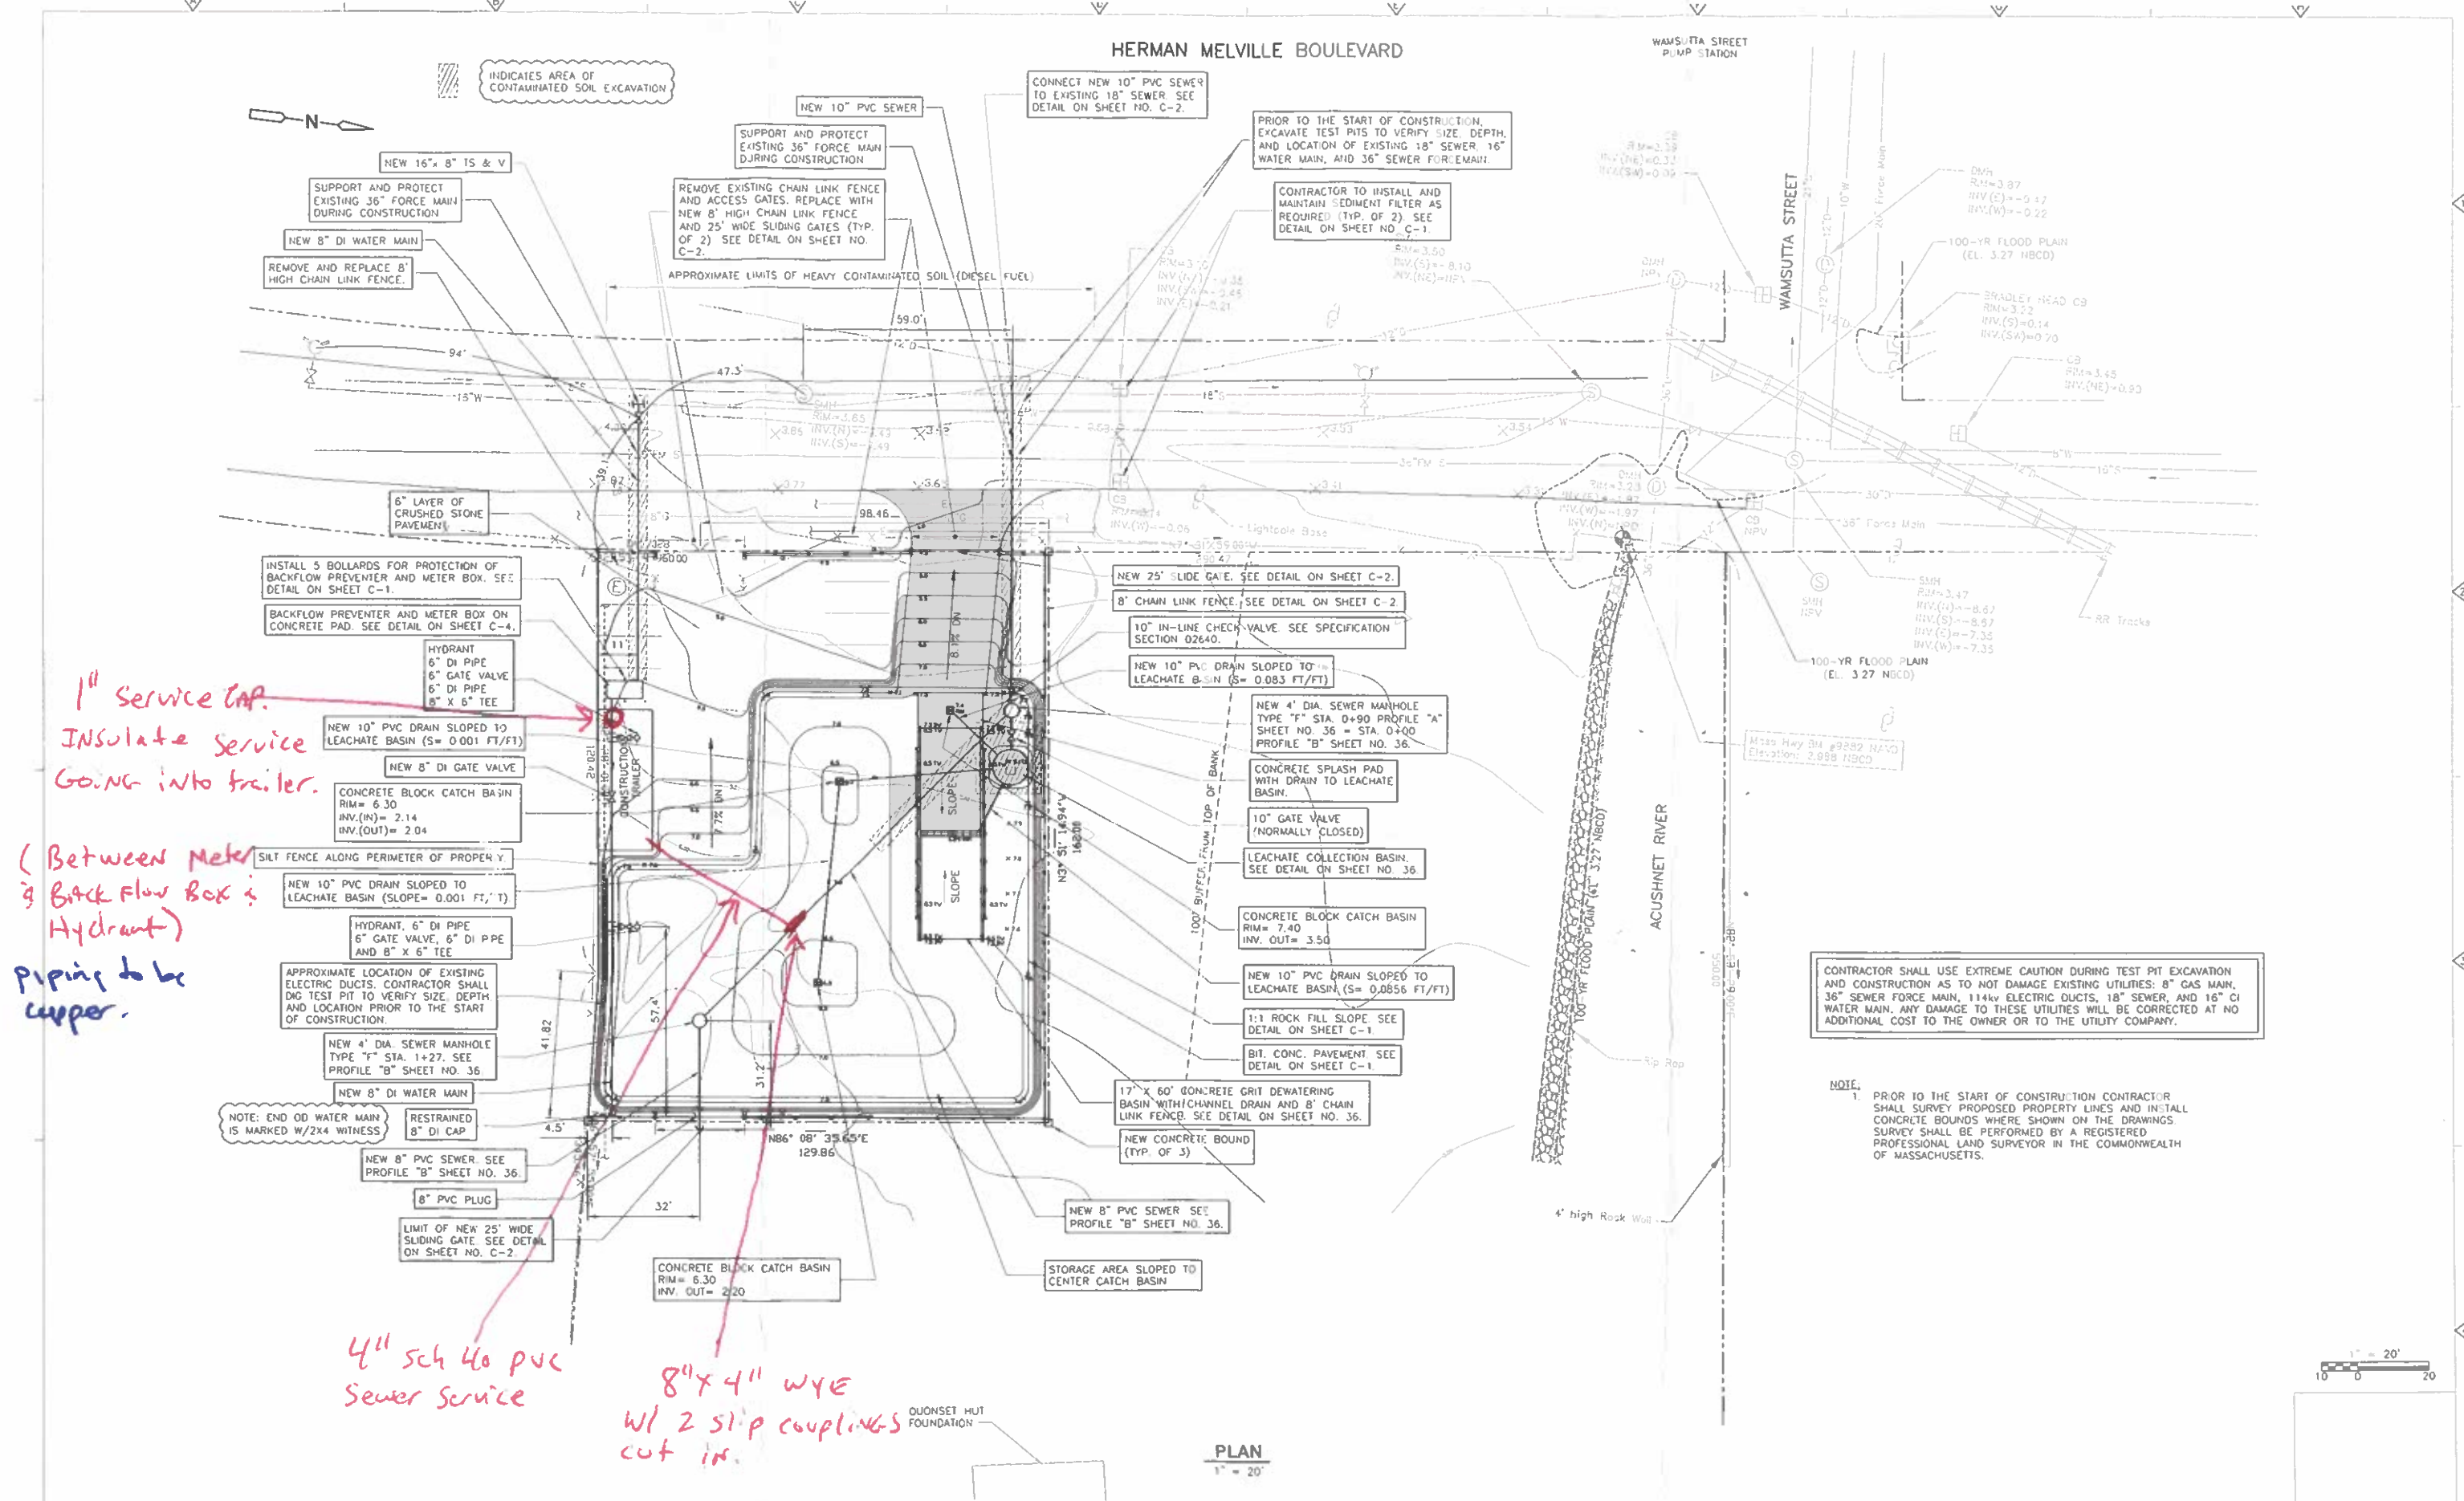

RECORD DRAWINGS

PACKER PROPERTY
GRIT DEWATERING AND STORAGE AREA
GRADING AND MATERIALS PLAN

PROJECT NO 0309-70514
FILE NAME CSTPL001
SHEET NO
35
Accession No: 0309-P-2745

REV. NO.	DATE	DRWN	CHKD	REMARKS
2	02/10	JC	SS/KS	REVISED FOR CONFORMED DRAWING

DESIGNED BY: M. SCHOTT
DRAWN BY: A. WELDON
SHEET CHECKED BY: S. SYDE
CROSS CHECKED BY: J. KEANEY
APPROVED BY: S. HICKOX
DATE: AUGUST 2009

CDM
Camp Dresser & McKee Inc.
58 Exchange Terrace
Providence, RI 02903
Tel: (401) 751-5300
consulting • engineering • construction • operations

CITY OF NEW BEDFORD, MASSACHUSETTS
WASTEWATER SYSTEM IMPROVEMENTS
INTERCEPTOR GRIT REMOVAL
AND REHABILITATION