

#8000416

use existing
number

SERVICE

34155

(Billing only)
inspection

NEW BEDFORD WATER WORKS

APPLICATION FOR SERVICE AND METER

NEW BEDFORD

02-17-2022 to 02-17-2023

I HEREBY ACKNOWLEDGE the receipt of a copy of the Regulations prescribed in the Ordinance of the City, for the use of Water, and I request that the water may be furnished through a

12 inch DI CL52 meter at 100 Duchaine Blvd.

P123 L67

#28051

at such rates as may from time to time be established by the City.

I hereby agree to pay promptly the bill for the Service pipe laid down for my premises, and to pay all dues for water, and I agree to conform to the said Regulations and to all provisions of the Water Ordinances, until written notice is given by me or my agent to cut off the supply.

Business
(line relocation)

SMR 100 LC

100 Duchaine Blvd.

* R Panel

TELEPHONE

Service laid Farland Corp

Size and kind of pipe

12"

DI

CL52

From

Service #28051

relocating to new spots at 100 Duchaine Blvd on west
of building, and extending water to service up east side of building

Turned on

appx 110 ft

Meter Set

appx 240 ft

Reading

Location

Building rates

Paid

Cost of Service

\$465

Paid

check 11097

31-727

SERVICE

34155

(Billing only)
inspection

NEW BEDFORD WATER WORKS

APPLICATION FOR SERVICE AND METER

NEW BEDFORD 02-17-2002 to 02-17-2003

I HEREBY ACKNOWLEDGE the receipt of a copy of the Regulations prescribed in the Ordinance of the City, for the use of Water, and I request that the water may be furnished through a

12 inch DI C52 meter at 100 Duchaine Blvd

P. 123

28051

at such rates as may from time to time be established by the City.

I hereby agree to pay promptly the bill for the Service pipe laid down for my premises, and to pay all dues for water, and I agree to conform to the said Regulations and to all provisions of the Water Ordinances, until written notice is given by me or my agent to cut off the supply.

Business
(line relocation)

SMR 100 LC

TELEPHONE

100 Duchaine Blvd
* R. Panel

Service laid Farland Corp

Size and kind of pipe 12" DI C52

From Service # 28051 relocating to new spots at 100 Duchaine Blvd on west

of building, and extending water to service up east side of building

Turned on

Meter Set

appx 110 ft

appx 240 ft

Reading

Location

Building rates

Paid

Cost of Service

\$ 465

Paid

31-727

THE FACE OF THIS DOCUMENT HAS A COLORED BACKGROUND ON WHITE PAPER AND ORIGINAL DOCUMENT SECURITY SCREEN ON BACK WITH PADLOCK SECURITY ICON.

Farland Corporation Inc.

21 Ventura Drive
Dartmouth, MA 02747
508-717-3479

Baycoast Bank

11097

53-7223/2113
9613

2 17 - 2002

PAY TO THE
ORDER OF

City of New Bedford

\$ 465.00

Four Hundred Sixty Five + ⁰⁰/₁₀₀

DOLLARS

MEMO

Water Supply Permit




AUTHORIZED SIGNATURE


MP

Security features included. Details on back.

100 DUCHAINC
34155
Dom N

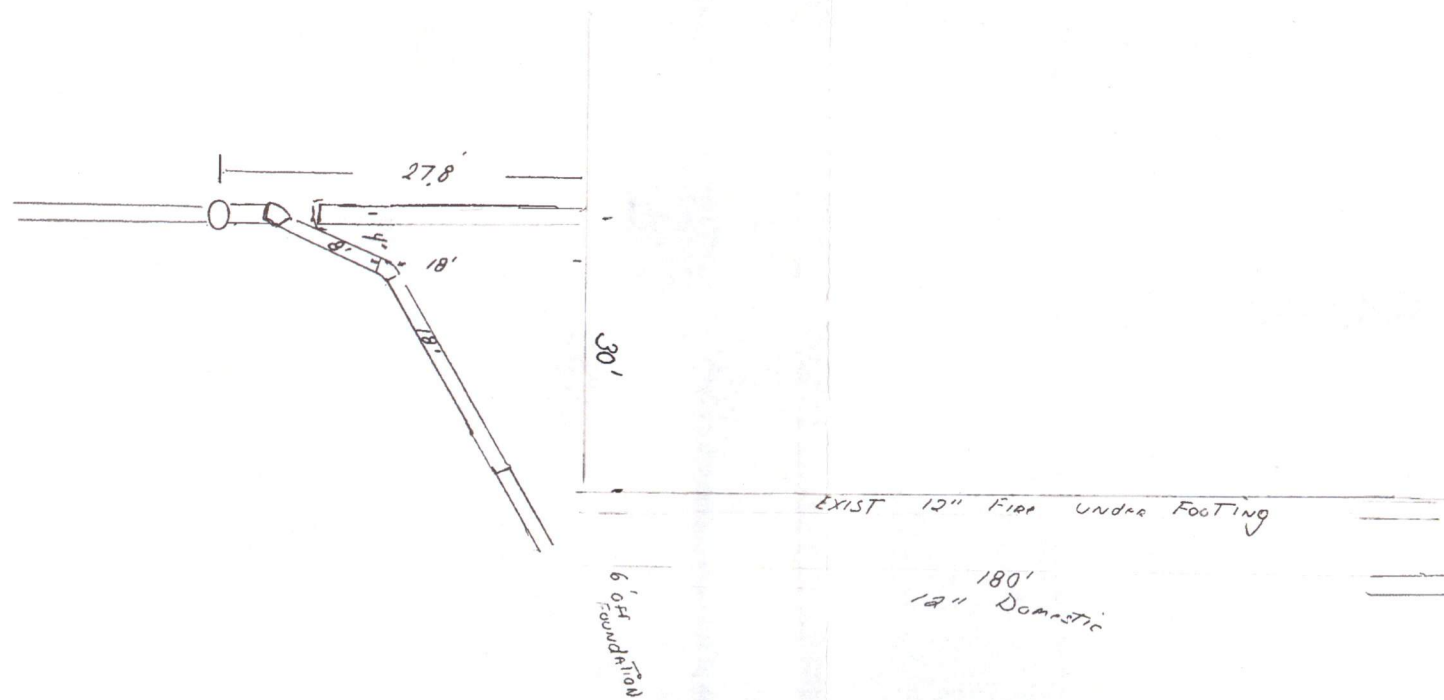

NOTES: 1. ALL UTILITIES SHOWN ARE BASED ON RECORD DRAWINGS AND FIELD SURVEY. 2. NO PART OF THIS DOCUMENT MAY BE REPRODUCED, STORED IN A RETRIEVAL SYSTEM, OR TRANSMITTED IN ANY FORM OR BY ANY MEANS, ELECTRONIC, MECHANICAL, PHOTOCOPYING, RECORDING, OR BY ANY INFORMATION STORAGE AND RETRIEVAL SYSTEM, WITHOUT THE WRITTEN PERMISSION OF FARLAND CORP. 3. ANY UNAUTHORIZED REPRODUCTION OF THIS DOCUMENT WITHOUT THE WRITTEN PERMISSION OF FARLAND CORP. SHALL BE CONSIDERED A VIOLATION OF FEDERAL AND STATE LAWS.

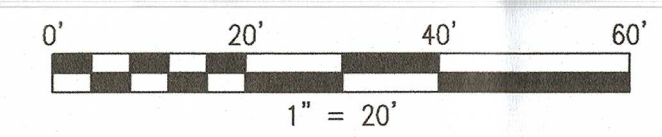

REVISIONS

1	9/13/19	CONSERVATION COMMENTS
2	10/15/19	PHASE I AND II
3	6/26/20	CONSERVATION COMMENTS
4	11/3/20	PLANNING COMMENTS
5	3/2/21	RPI COMMENTS

www.FarlandCorp.com

401 COUNTY STREET
NEW BEDFORD, MA 02740
P.508.717.3479
OFFICES IN:
•TAUNTON
•MARLBOROUGH
•WARWICK, RI

DRAWN BY: MJW/JT
DESIGNED BY: CAF
CHECKED BY: CAF

SITE PLAN

100 DUCHAINE BOULEVARD
ASSESSORS MAP 133 LOT 67
ASSESSORS MAP 134 LOTS 5 & 462
NEW BEDFORD, MASSACHUSETTS

PREPARED FOR:
PARALLEL PRODUCTS OF NEW ENGLAND
401 INDUSTRY ROAD
LOUISVILLE, KY 40208

JULY 3, 2019

SCALE: 1"=20'

JOB NO. 15-500.2

LATEST REVISION:
MARCH 2, 2021

UTILITIES

SHEET 13 OF 26