

0.9

1994-6-3

ff

W X W Hemlock St.

Hemlock St. Rivet St.

12.5 ft. 7.0

Set: November 1994

from Hydrant

line

line


from W

from S

OPEN TO THE RIGHT

Record Dwg. No.

No. of Turns:

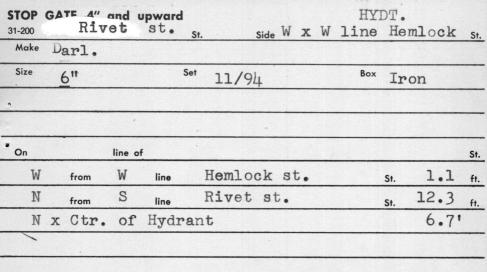

OPEN TO THE RIGHT