

SERVICE

#157 Application No. 22377

St. & No. N.W. Cor. Park Avenue & Mary Street


Size Pipe	3/4"	Kind Pipe	Copper	Laid	5-2-47
S	from	N	Line Park Avenue	St.	5.7 ft.
W	from	W	line Mary St.	St.	12.8 ft.
E	from	E	line House	St.	5.3 ft.

REMOVED: 11/5/86

City	23	ft. Earth	Taker		
			Labor	ft. Earth	75
	20	ft. Pipe	6	ft. Pipe @ .33	1 98
			Service charge		32 00
			Total		34 73

11-7-56, ser. extended 4 ft. around a sewer manhole which was installed by the street dept. recently, as per sketch. Used 4 ft. 3/4" cop. tubing, type K. soft, 2-3/4" cop. to cop. cplg. A-1525.

Ave.

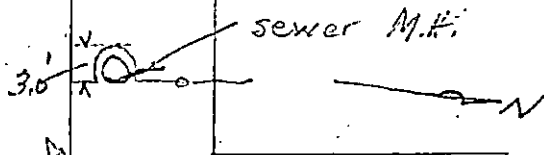

11/5/66-Serv. shut off & cut off at tap (36" main) stop box removed at sidewalk. Copper left in ground between main & prop. line.

Mary

Park

36" main

5 ft.