

APPLICATION No.: 23808

TAP CLEARED

LOCATION: 1310 E.S. Rockdale Ave., N x Durfee

OWNER: Antone E Perry Jr.

MEASURES: $1\frac{1}{2}$ " Copper 8-1-52
 S from S line Gardner 252.5 ft.
 W from E line Rockdale Ave. 6.4 ft.
 On so line of meter box

 November 28, 1956 The following stock was used repairing service # 23808 - $1\frac{1}{2}$ " (see sketch attached)

19 ft. $1\frac{1}{2}$ " copper tubing 1 $1\frac{1}{2}$ " corporation
 2 $1\frac{1}{2}$ " cop. to cop. cplg. 4 lbs. leadite and $1/4$ lb. braided
 1 $1/4$ " c.i. gate box, complete jute


Service #23808 line is 33.8 ft. N X S line Sawyer St.. This service was laid with $1\frac{1}{2}$ " copper tubing and was reduced to $1\frac{1}{2}$ " somewhere along the line and at another point it was reduced to 1" copper. Location of $1\frac{1}{2}$ " corporation installed into the hydrant tee plug at the end of the 8" cement lined main pipe:

E x E line Rockdale Avenue 340.5 ft.
 N x S line Sawyer Street 18.0 ft.
 E x center of the hydrant 1.5 ft.

Service #23808 was shutoff at the curb stop and at a point in the Sawyer Street - see broken line in sketch - the copper tubing was cut off and abandoned in place.

19 ft. of new copper line was installed at a point where the copper tubing was cut off and run across Sawyer Street and then connected into a $1\frac{1}{2}$ " corporation which was installed into the hydrant tee plug at the terminus of the 8" cement asbestos pipe line in Sawyer Street. ($1\frac{1}{2}$ " copper tubing was installed). The master meter was removed from the meter pit and returned to the meter shop.

DATE	BEF.	AFT.	REMARKS

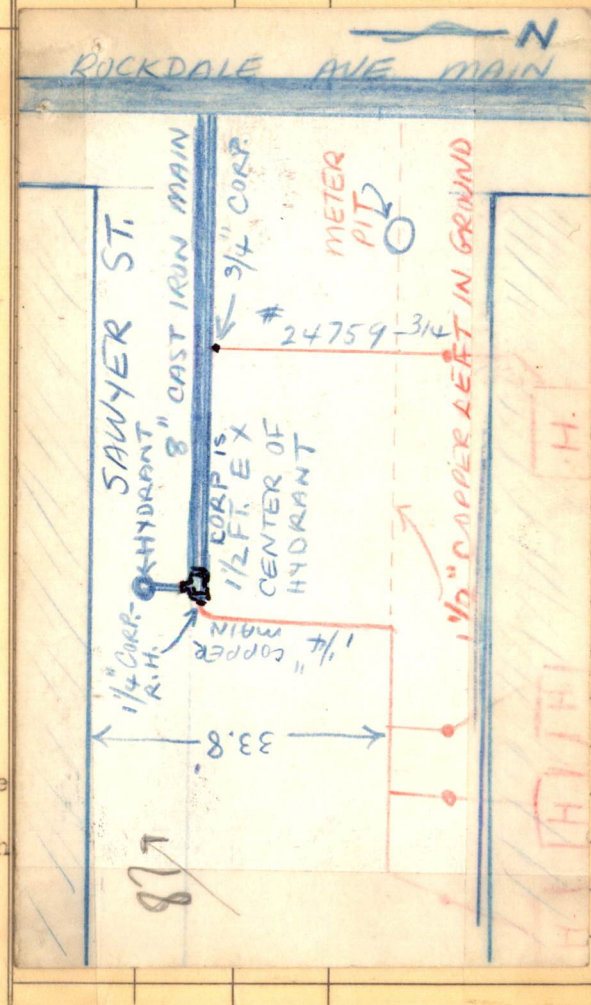

[illegible][illegible]