

~~450~~ ^{NEW} APPLICATION No.: 31043
 LOCATION: E.S. Plainville Rd. N x Tarkiln Hill Rd.
 OWNER: Sean F. Daly WILLOWS at Tarkiln Hill

MEASURES: 8" Ductile Pipe June 16, 1988
 N x Tarkiln Hill Rd. 693.0 ft.
 W x stone wall 7.0 ft.
 N x stone wall 10.0 ft.

see service card for stock (bends)

EMERGENCY CONNECTION ONLY - MUST STAY IN OFF POSITION

Stock supplied & installed by Contractor:


1 - 8" x 8" x 8" Tee, mech.
 8.7 ft. - 8" ductile pipe
 8" 1/4 Bend, mech.
 54 ft. - 8" Ductile pipe
 8" 1/8 Bend, mech. -----
 3 ft. - 8" ductile pipe----- under sewer drain
 8" 1/8 Bend, mech. -----
 3 ft. - 8" ductile pipe
 8" 1/8 Bend, mech.
 7 ft. - 8" ductile pipe
 8" 1/8 Bend, mech.
 22 ft. - 8" ductile pipe
 8" Gate valve, mech. Mu.-----

Insp.....\$ 9.77
 Turn on charge.....\$ 25.00

total \$34.77

TAP CLEARED

DATE BEF. AFT. REMARKS

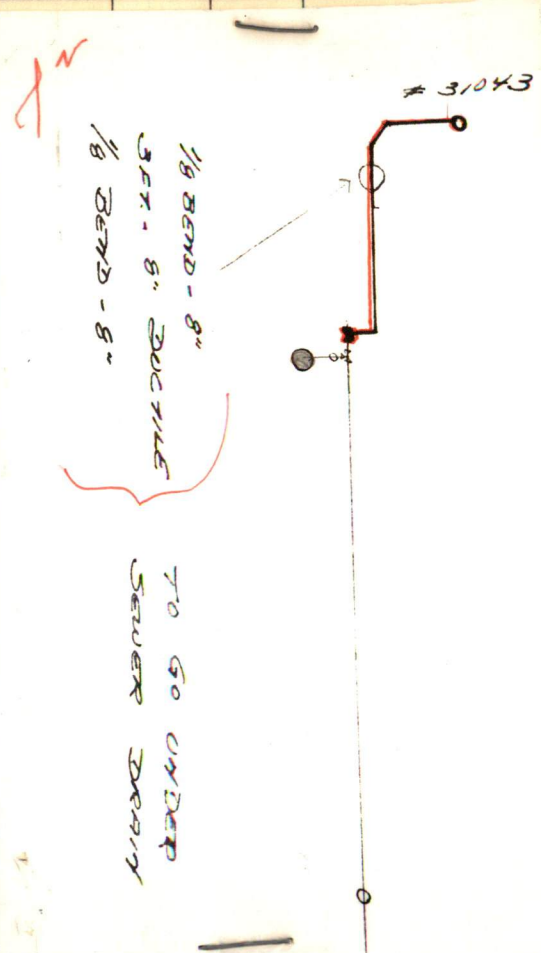

METER HISTORY

[illegible]

CHARGE OUTS