

33906

LOCATION: 1056 Kings Hwy

31-313

MEASURES:

6" fire supply

ductile

E x E line

Tarklin Hill

38.5'

E x

build ext

40.5'

W x E line

build

6.5

S x S line

build

82'

pipe inside property

80.6'

contractor : Eric Smith

inspected Percy

TAP CLEARED

DATE _____

BEF.


AFT.

REMARKS

[illegible]

CHARGE OUTS

[illegible]

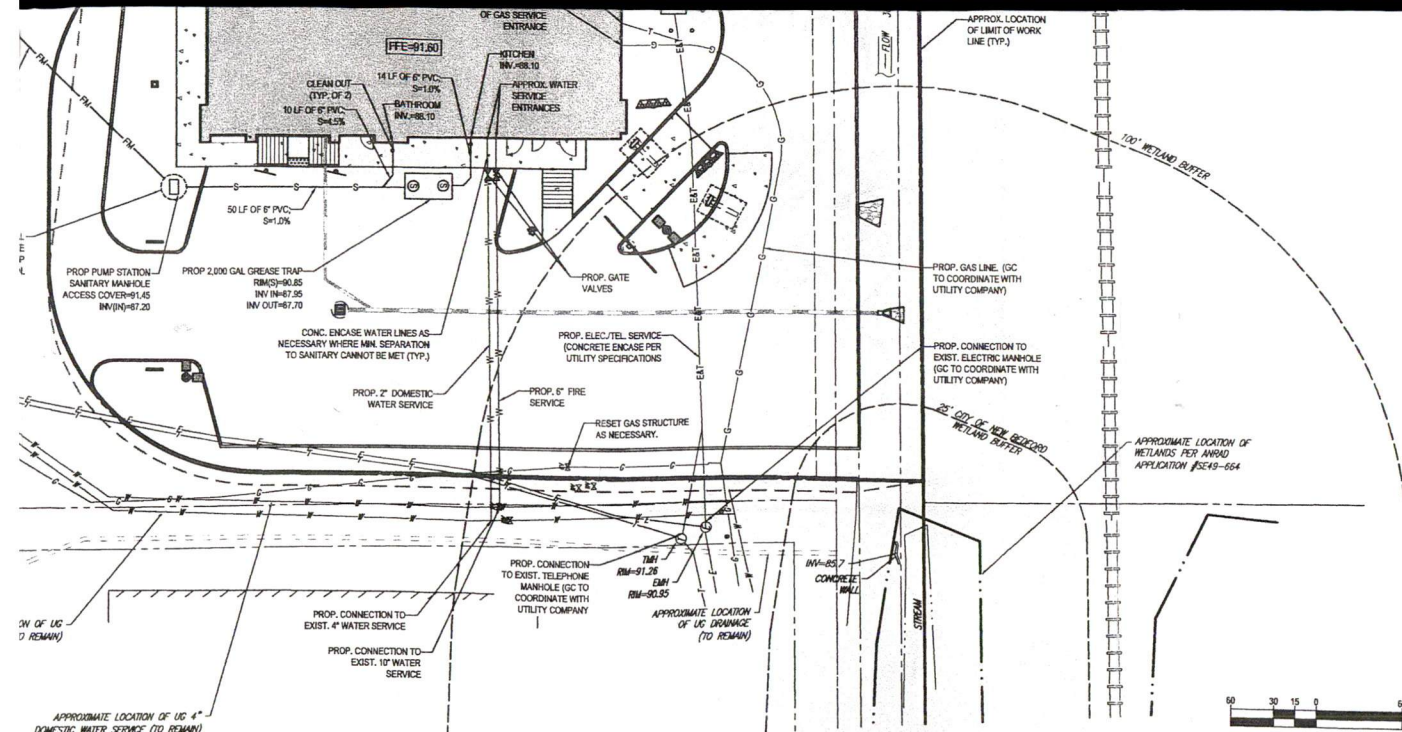

**BOHLER
ENGINEERING**

CIVIL & CONSULTING ENGINEERS
SURVEYORS
PROJECT MANAGERS
ENVIRONMENTAL CONSULTANTS
LANDSCAPE ARCHITECTS

352 TURNPIKE ROAD
SOUTHBOROUGH, MA 01772
Phone: (508) 480-9900
Fax: (508) 480-9080
www.BohlerEngineering.com

OFFICES:

- WARREN, NJ
- UPTATE NEW YORK
- BOSTON, MA
- NEW YORK, NY
- PHILADELPHIA/SOUTHERN NJ
- LEHIGH VALLEY, PA
- SOUTHEASTERN PA
- BALTIMORE, MD
- SOUTHERN MARYLAND
- NORTH ERM VIRGINIA
- WASHINGTON, DC
- CENTRAL VIRGINIA
- CHARLOTTE, NC
- RALEIGH, NC

THE INFORMATION, DESIGN AND CONCEPT OF THIS PLAN ARE PROPRIETARY AND SHALL NOT BE COPIED OR USED FOR ANY PURPOSES WITHOUT PRIOR WRITTEN AUTHORIZATION FROM BOHLER ENGINEERING. ONLY APPROVED, SIGNED AND SEALED PLANS SHALL BE UTILIZED FOR CONSTRUCTION PURPOSES. © 2004 BOHLER ENGINEERING.

THIS PLAN TO BE UTILIZED FOR
UTILITIES PURPOSES ONLY

REFER TO GENERAL NOTES SHEET
FOR GRADING & UTILITY NOTES

STREET ADDRESS 1080 KINGS HIGHWAY		
CITY NEW BEDFORD	STATE MASSACHUSETTS	
COUNTY PROVIDENCE COUNTY		
SITE ID # 020-0128	PLAN DESCRIPTION UTILITY PLAN	
STATUS		DATE
DRAWN BY:		8/12/15
PLAN CHECKED		JAK
AS-BUILT		
SHEET NO.		C-7
		OF 15

CITY CLERK

M014 A 10-52

McDonna

THESE PLANS AND SPECIFICATIONS ARE THE PROPERTY OF MCDONNELL & COMPANY, INC. AND SHALL NOT BE REPRODUCED WITHOUT THEIR WRITTEN PERMISSION.

NORTH EAST REGION
680 CANTON STREET
WESTWOOD, MA

PLAN APPROVALS
SIGNATURE

APPROVED MCDONNELL'S AGENT