

DRAIN

#68

Permit

No. 1046-1904

Park St.

Arnold to Union

Enters Park St Sewer

5" pipe

May 3-1904 at 1 P.M. BY F. C. DE MELLO

From property of

Jeanette McLeod

Located

E.S. Park north of Arnold

Account Misc. Ledger

page


Reconnected - "West End
Sewer Separation Project"

CDM ~

As Built 09/1999
See Case B.

Park

Arnold

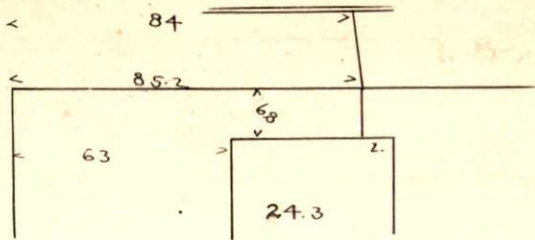

N.