

#98

DRAIN

Permit

No. 11680-22

Maple St.
w. of Chancery.
enters Maple St. Sewer.
6" pipe.

July 15, 1922.

From Property of

Mary T. Howland.

Located

s.s. Maple.


Account Misc. Ledger

Reconnected - "West End
Sewer Separation Project"

CDM~

As Built 09/1999
See Case B

Chancery St.

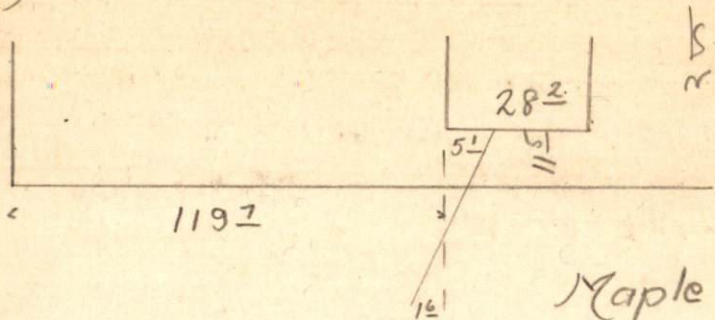

Maple St.