

DRAIN

(#6 Stetson St.)

Ash St.

Permit

No. 14165-26

N.
W. of Bedford St.

enters Ash St. Sewer
6" Pipe

May 20, 1926

From Property of Delia F. Smith

Located W. S.

Account Misc. Ledger

Reconnected - West End


Sewer Separation Project"

CDM~

As Built 09/1999

See Case B

Stetson St.

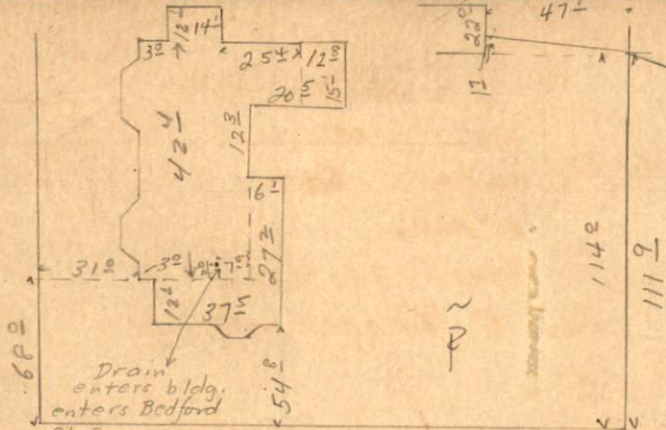

Bedford St

Ash St.