

DRAIN

Permit

No.

14170-26

Park St.
Smith to Sycamore
enters Park St. Sewer.
6" pipe.

July 1926.

From Property of

Hannah E. Macy.

Located

W.S.

Account Misc. Ledger


Reconnected - "West End

CDM ~

Sewer Separation Project"

As Built 09/1999

Park St.

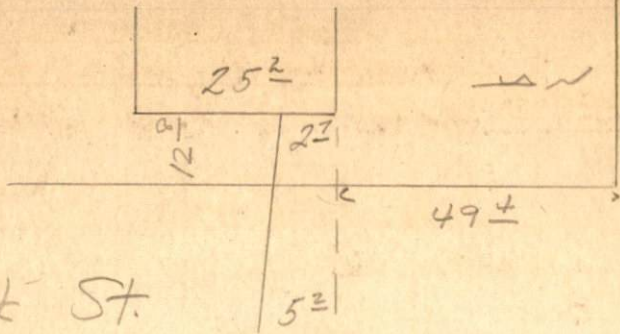

Smith St.

25
25
25
25