

DRAIN

#213

Permit

No. 15579-49

NORTH ST.

n.s.

Chancery to Park St.

enters North St. sewer

From Property of

Dorothy M. Sweet

Located

Amount Misc. Ledger

Reconnected - "West End
Sewer Separation Project"

H. S. HUTCHINSON & CO.


CDM~

AS Built 09/1999

See Case B

Park St.

Park

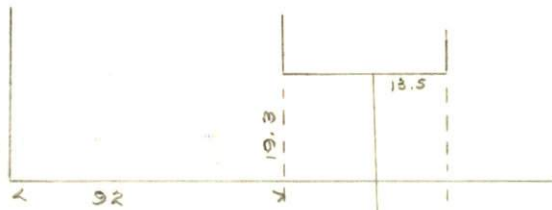

North St

